


T. 40 S., R. 14 W., W.M.

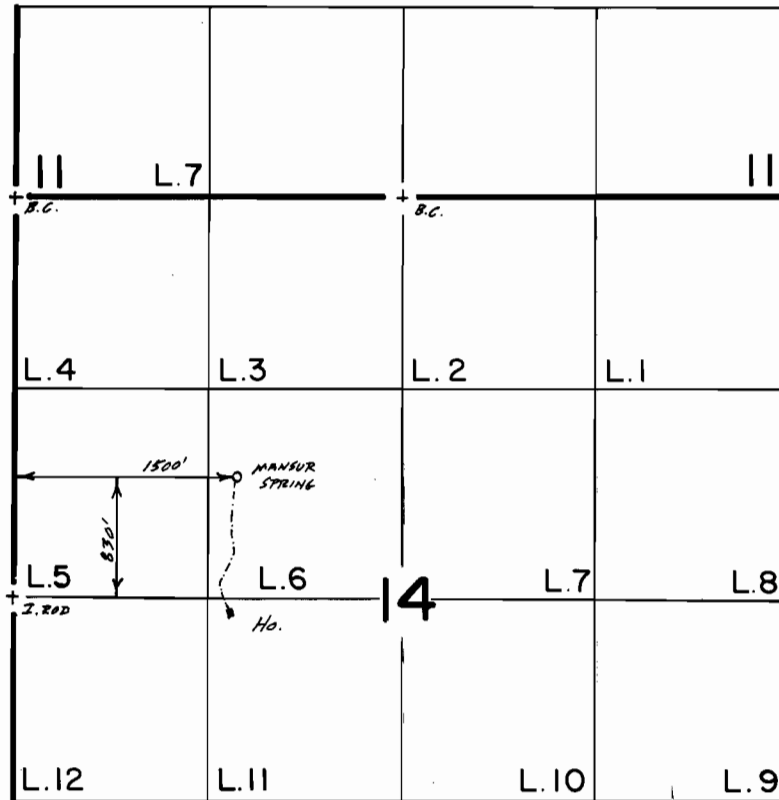

Scale 1"=1320'

FINAL PROOF SURVEY
UNDER

Application No. 57922. Permit No. 43730.....
IN NAME OF

DOUG HOWARD MANSUR.....

Surveyed Sept. 30, 1987, by B.S. JAMES.....