


T. 40 S., R. 14 W., W.M.

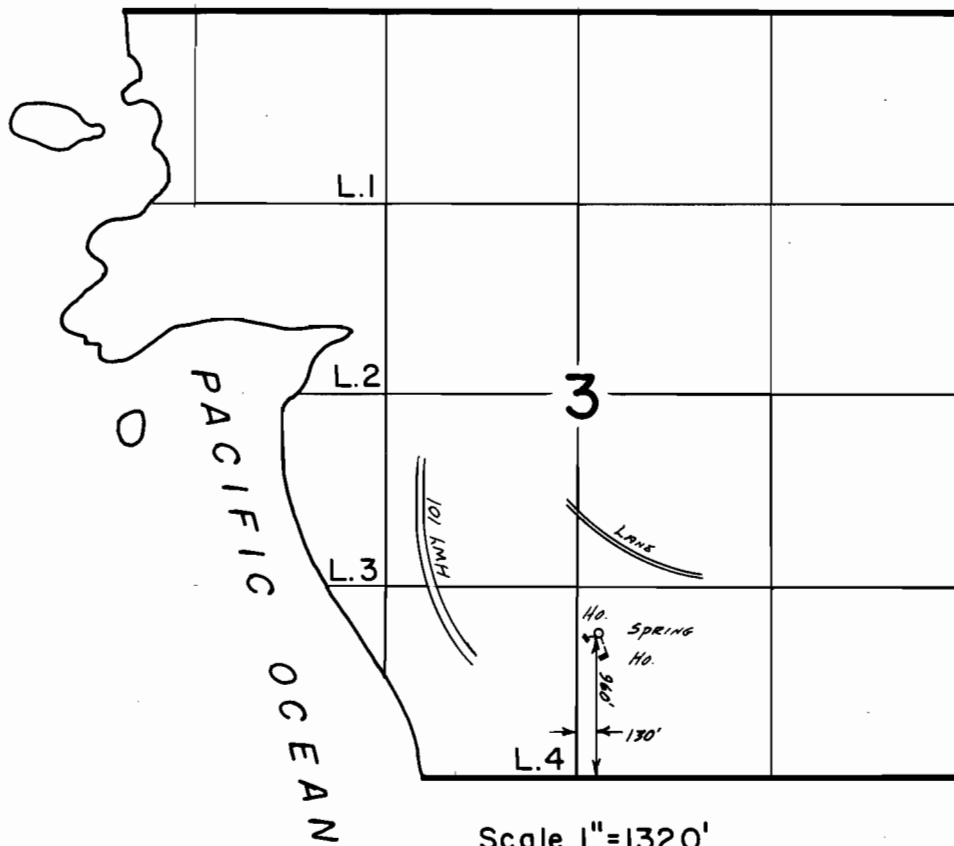

FINAL PROOF SURVEY
UNDER

Application No. 57966. Permit No. 43679.
IN NAME OF

W. M. GRAHAM

Surveyed Sept. 29, 1987, by J. KAUPPILA.