


T.24S., R.7W., W.M.  
SECTION 21

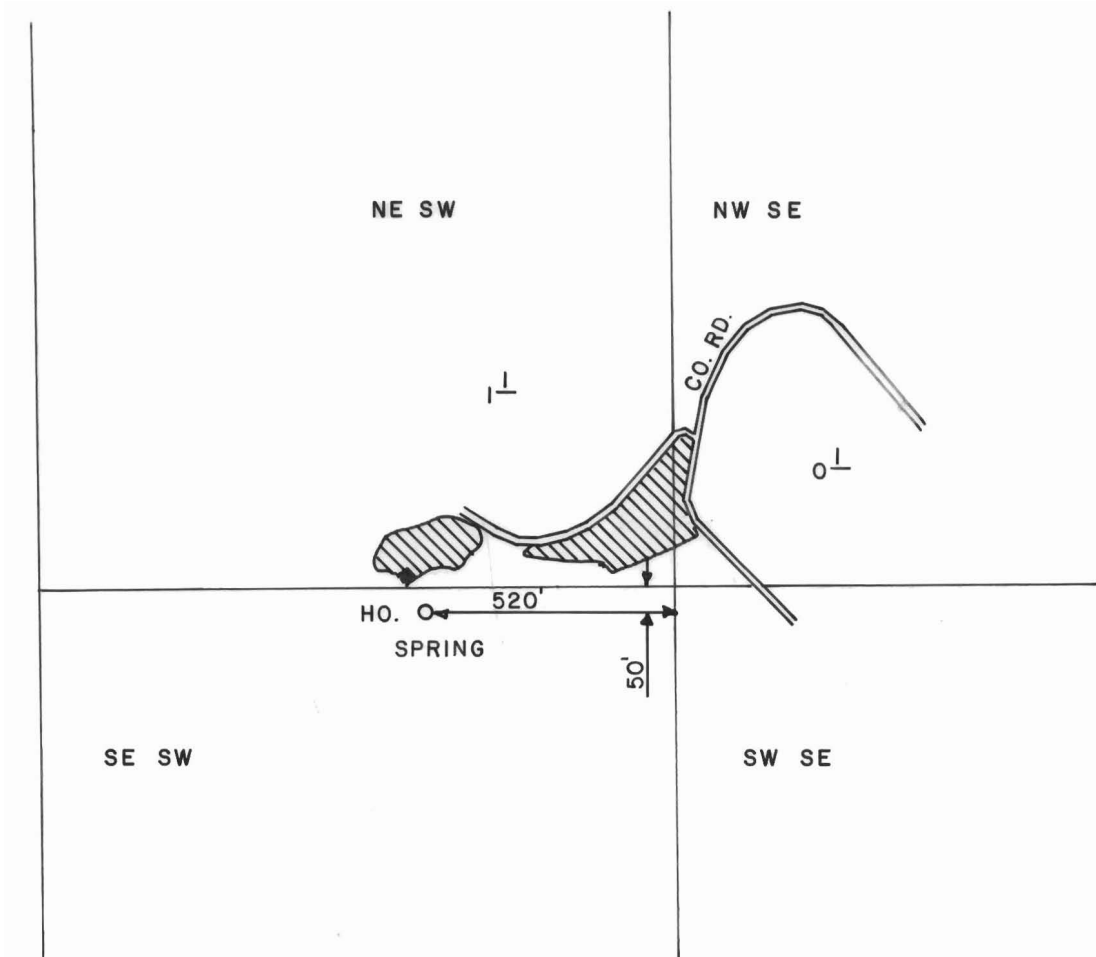

SCALE: 1" = 400'

**FINAL PROOF SURVEY**  
UNDER

Application No. 57983... Permit No. 43626.....  
IN NAME OF

**ARTHUR E. & JUDITH L. REEVES**

Surveyed AUG. 14, 1986, by J.M. SCHMORDE