


T. 29 S., R. 7 W., W.M.

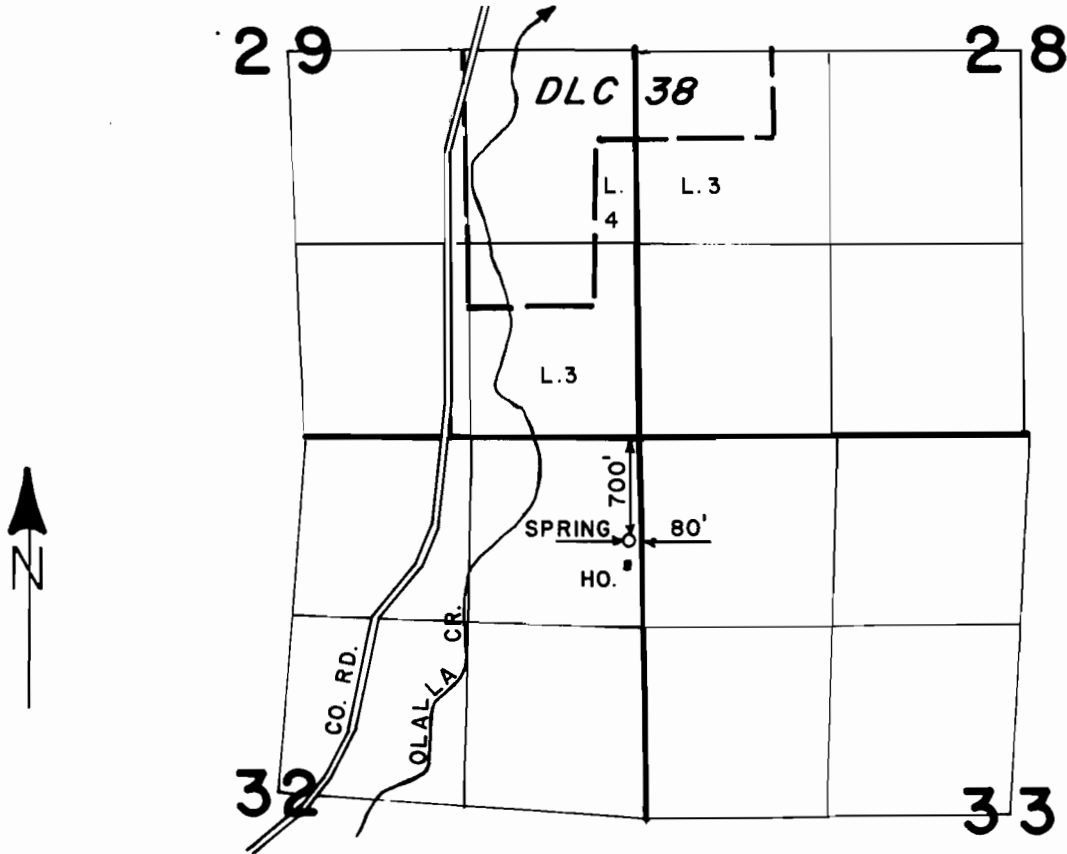

SCALE: 4" = 1 MILE

FINAL PROOF SURVEY UNDER

Application No. 58078 Permit No. 43792
IN NAME OF

TERRY & JUDY MCCURDY

Surveyed JULY 14, 1987, by J.M. SCHMORDE