


T.1N., R.39E., W.M.

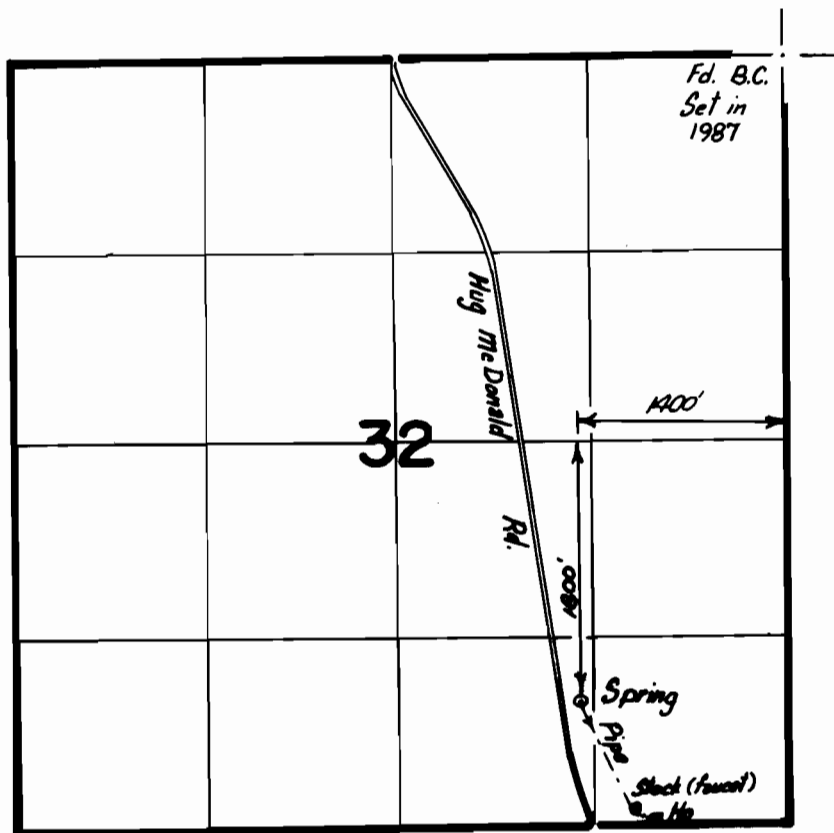

FINAL PROOF SURVEY
UNDER

Scale : 1" = 1320'

Application No. **58084** Permit No. **43726**
58210 **43832**
IN NAME OF

LAWRENCE & ELEANOR STARR

Surveyed 10-29 1987, by Vern Church