


T. 30 S., R. 5 W., W.M.

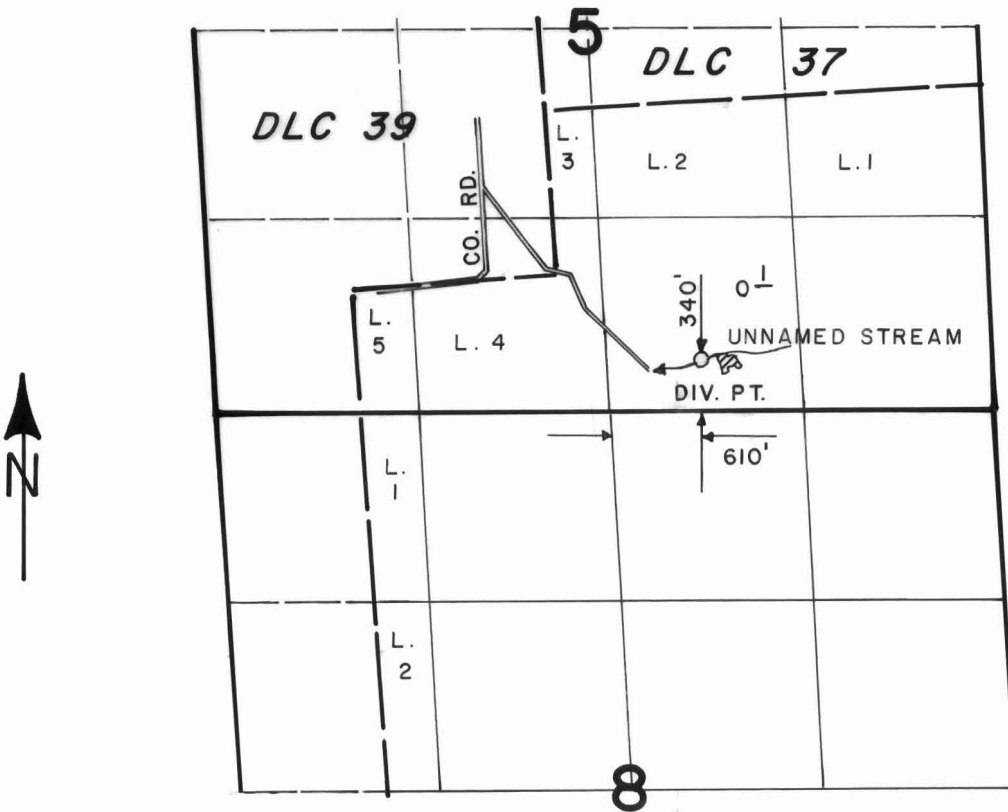

SCALE: 4" = 1 MILE

FINAL PROOF SURVEY
UNDER

Application No. 58485. Permit No. 44128.....
IN NAME OF

DUANE E. OSBORN

Surveyed JUNE 19, 1984, by L. E. CASHION