


P-44218

T.13 & 14S., R.30E., W.M.

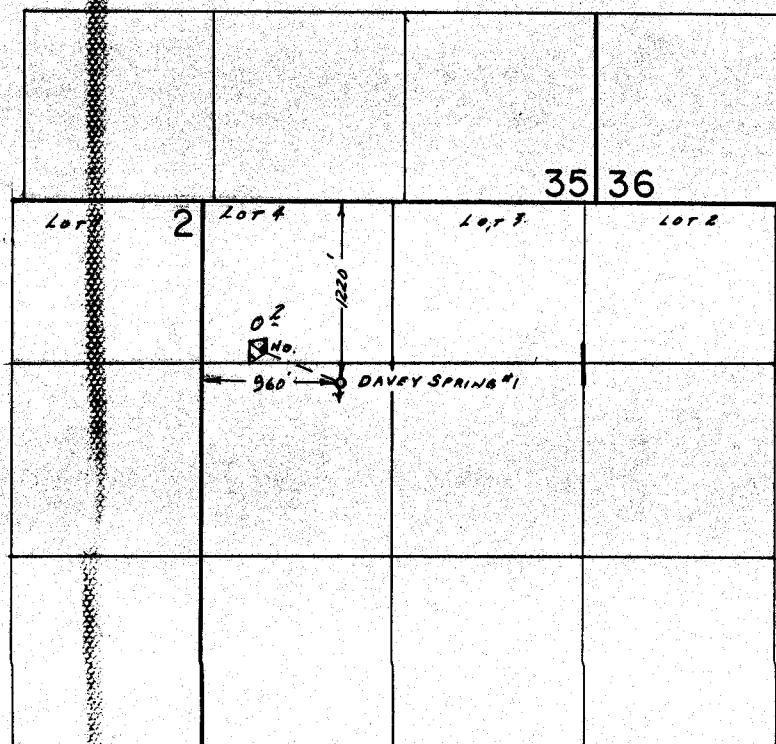

SCALE: 1" = 1320'

FINAL PROOF SURVEY
UNDER

Application No. 58652.. Permit No. 44218.....
IN NAME OF

DAVID FRONAPEL

Surveyed July 8..... 1987., by V.L. CHURCH.....

4/19/89 AWB

41023-179-3142