


T.4S. R.13E. W.M.

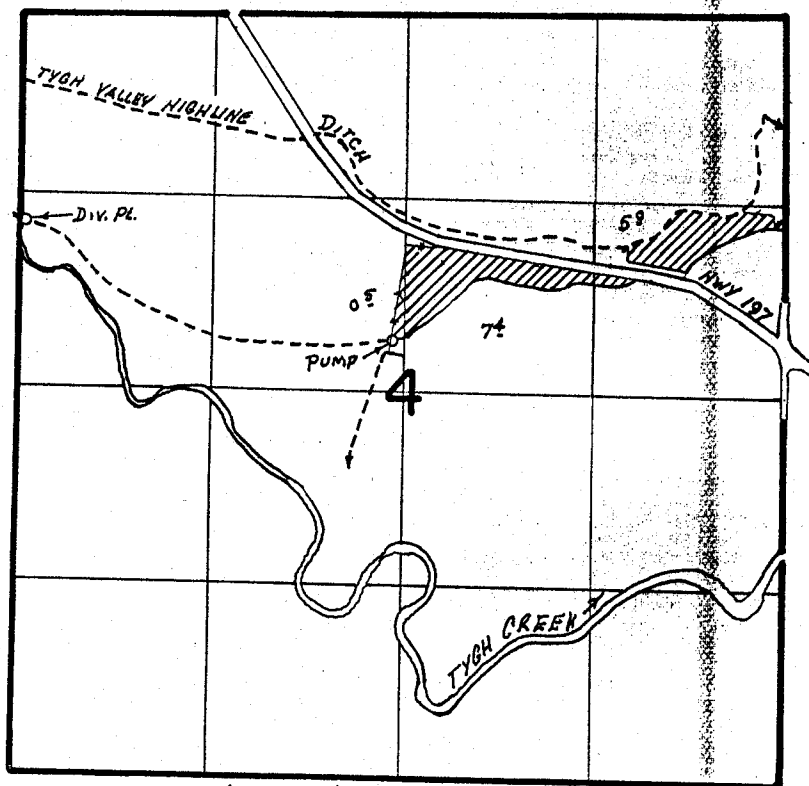

DIV. PL. LOC. 1410' S 1 30' E FROM THE NW COR. SEC. 4

FINAL PROOF SURVEY
UNDER

Application No. 58721... Permit No. 44565
IN NAME OF

.....
Surveyed May 11, 1983, by T. J. Paul.....