


T.29S., R.1W., W.M.

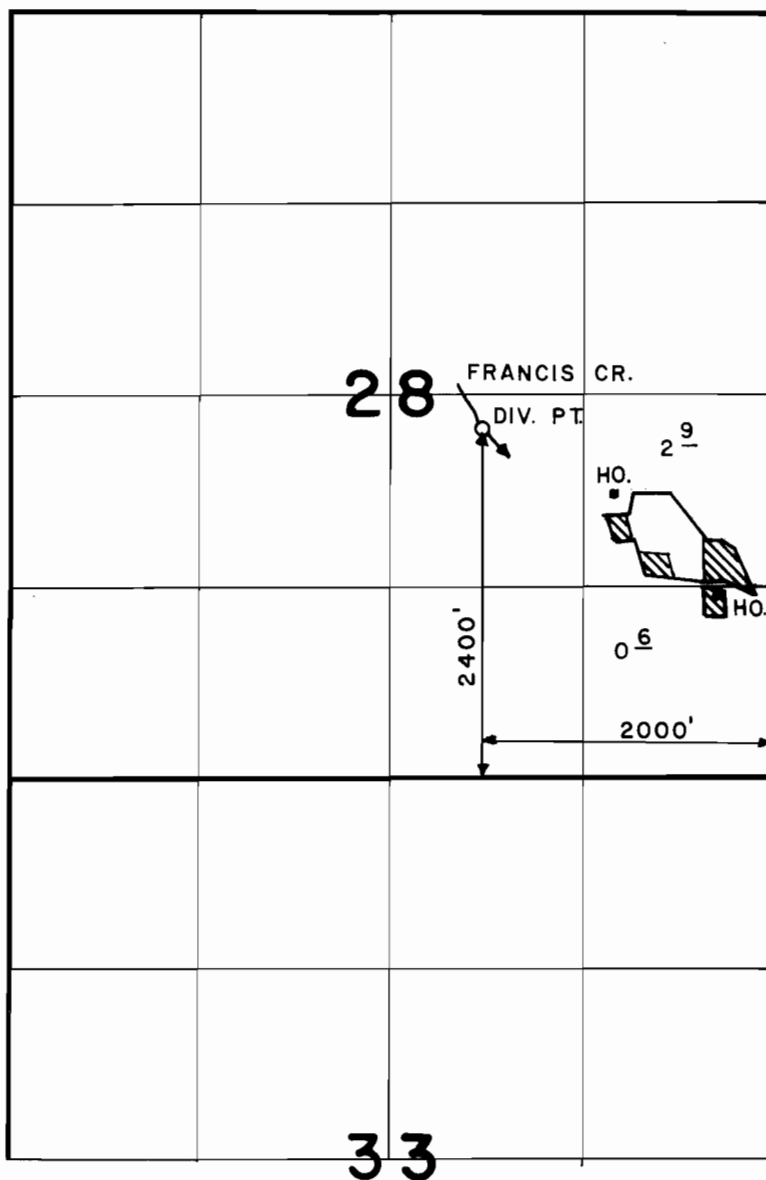

SCALE: 4" = 1 MILE
FINAL PROOF SURVEY
UNDER

Application No. 58837 Permit No. 44694
IN NAME OF

RONALD H. & DIANA L. LIZOTTE AND FRANK DIXON

Surveyed JUNE 11, 1985, by D.K. CLARK