


T. 40S., R. 14W., W. M.

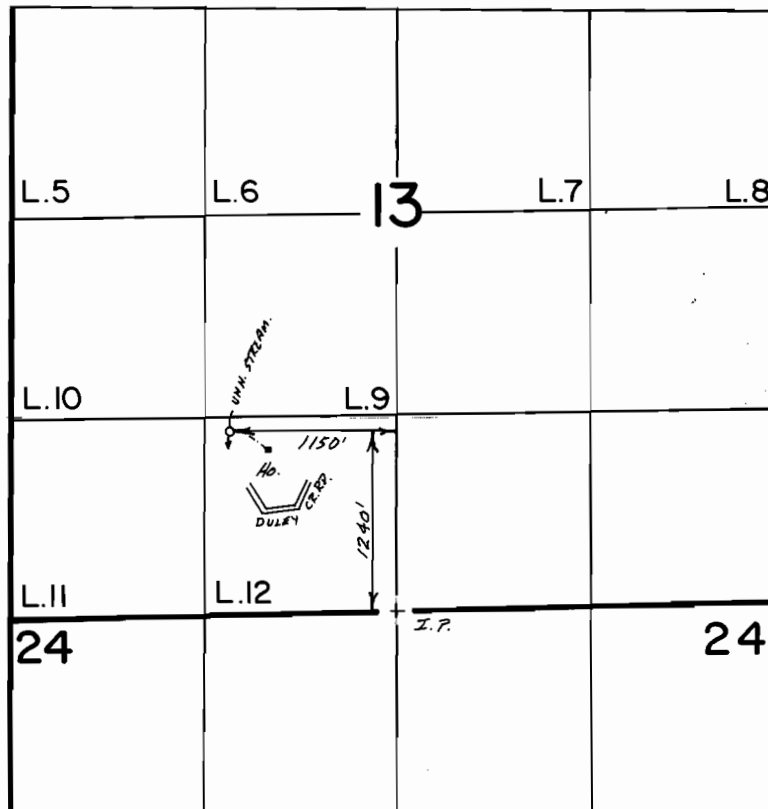

Scale 1" = 1320'

FINAL PROOF SURVEY UNDER

Application No. 58885 Permit No. 44362...
IN NAME OF

LORNA C. WILSON

Surveyed Sept. 28, 1987, by B.S. JAMES