


T. 40 S., R. 14 W., W.M.

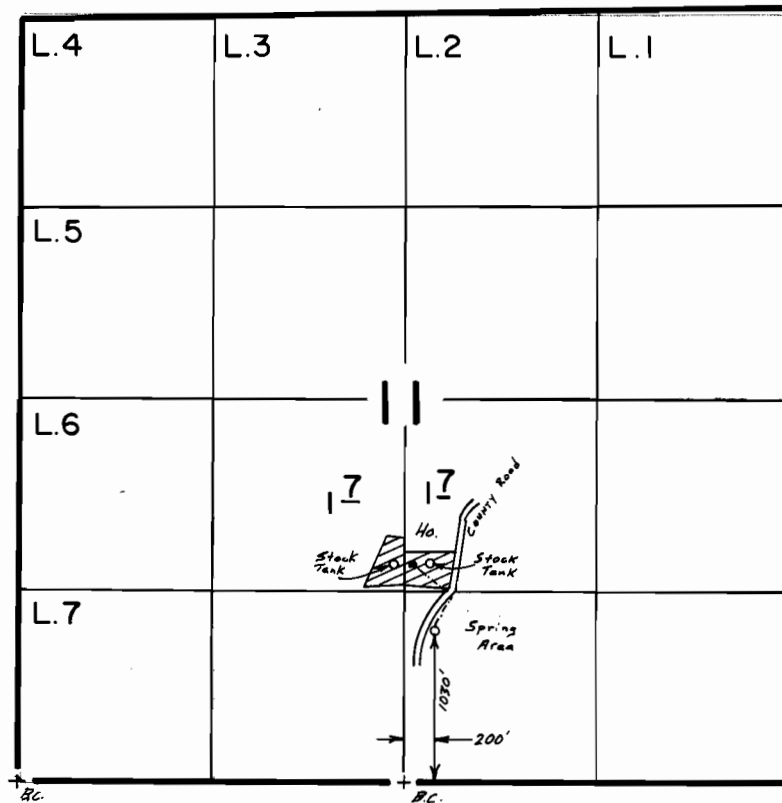

Scale 1"=1320'

FINAL PROOF SURVEY UNDER

Application No. 59230.. Permit No. 44.831.....
IN NAME OF

.....C. GALE.....RUSH.....

Surveyed Sept. 2., 19.87, by J. KAUPPILA..