


# T. 27S., R. 5W., W.M.

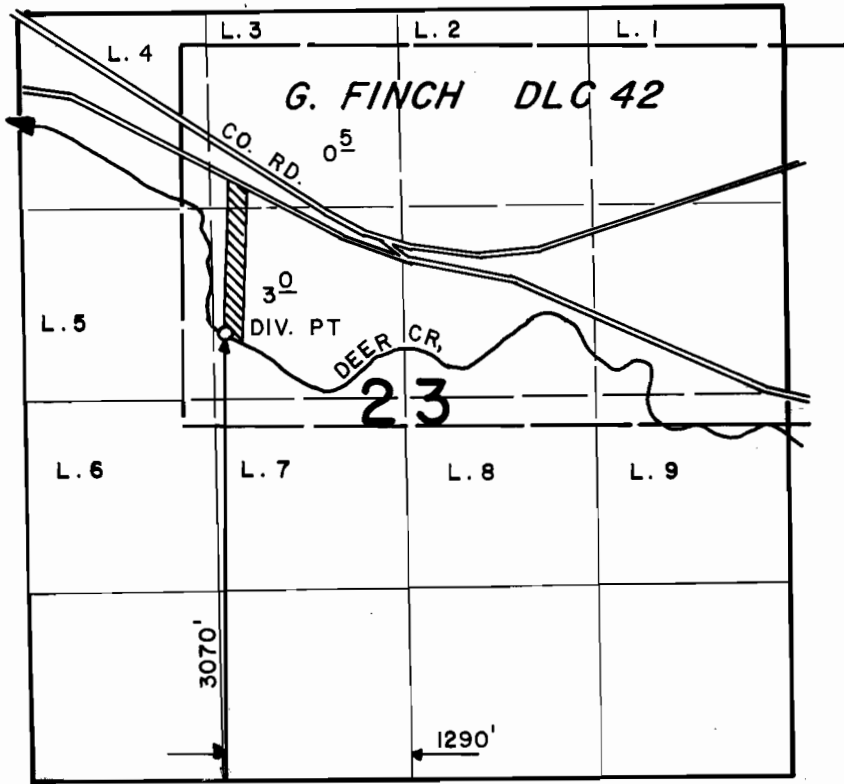

SCALE: 4" = 1 MILE

## FINAL PROOF SURVEY UNDER

Application No. 59291 Permit No. 44638  
IN NAME OF

SUSAN L. RULEY

Surveyed SEPT. 23 1987, by J.M. SCHMORDE