


T.30S., R.2W., W. M.

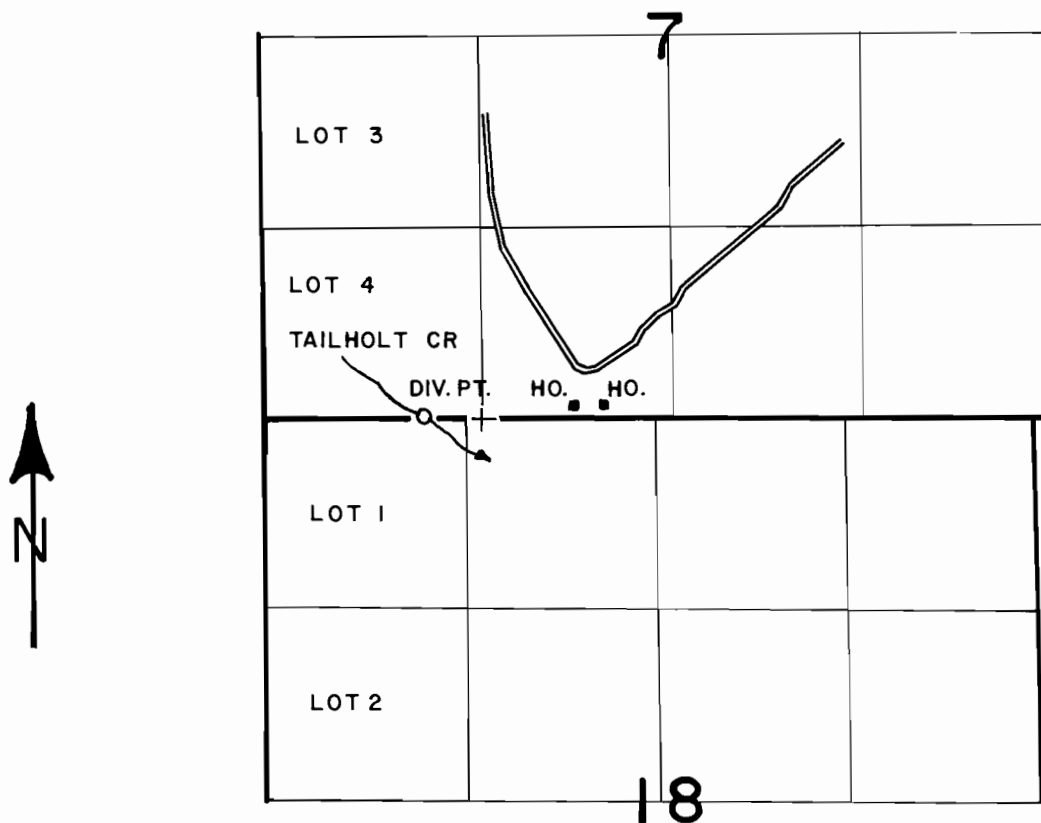

DIVERSION POINT LOCATED 30 FEET NORTH AND 1090' EAST FROM SW CORNER SECTION 7.

SCALE: 4" = 1 MILE

FINAL PROOF SURVEY UNDER

Application No. 59727... Permit No. 45247.....
IN NAME OF

WILLIAM RAY SMITH

Surveyed JULY 30, 1987., by J.M. SCHMORDE