


T. 28 S., R. 13 W., W.M.

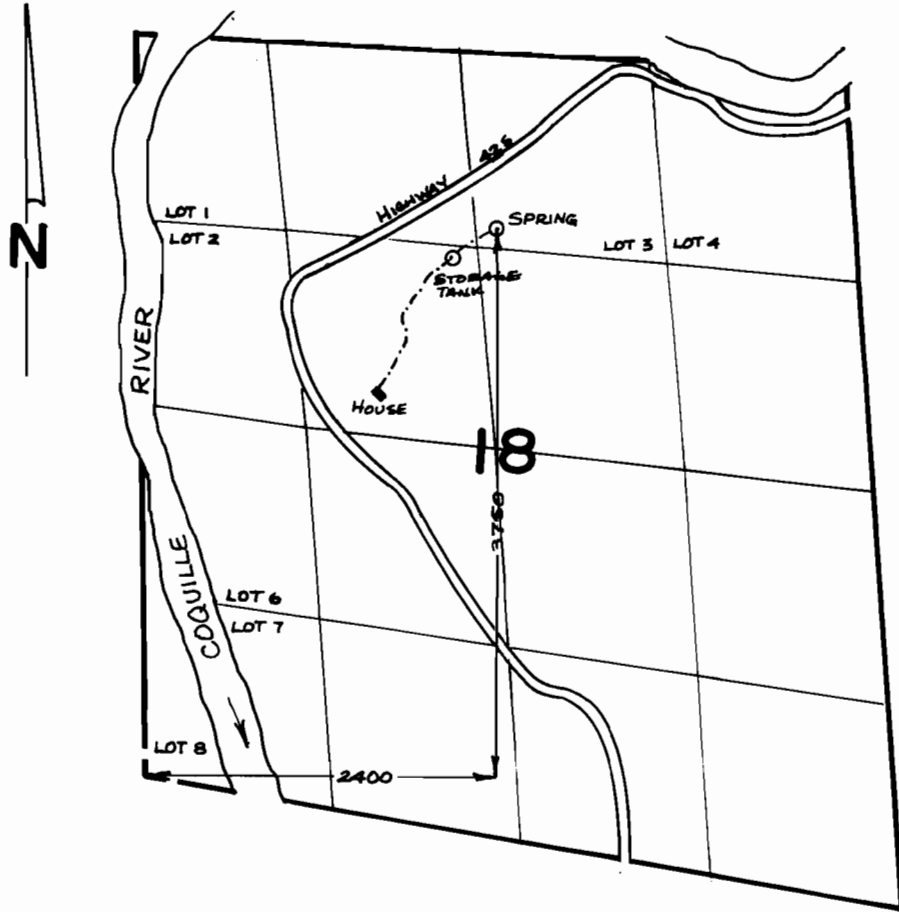

SCALE : 4" = 1 MILE

FINAL PROOF SURVEY UNDER

Application No. ...597.60. Permit No.44933...
IN NAME OF

WILLIAM W. PAYTON & HELEN M. PAYTON

Surveyed ...9/1..... 19.84, by ...M. SCHMORDE...