T. 8S., R. 19E., W.M.

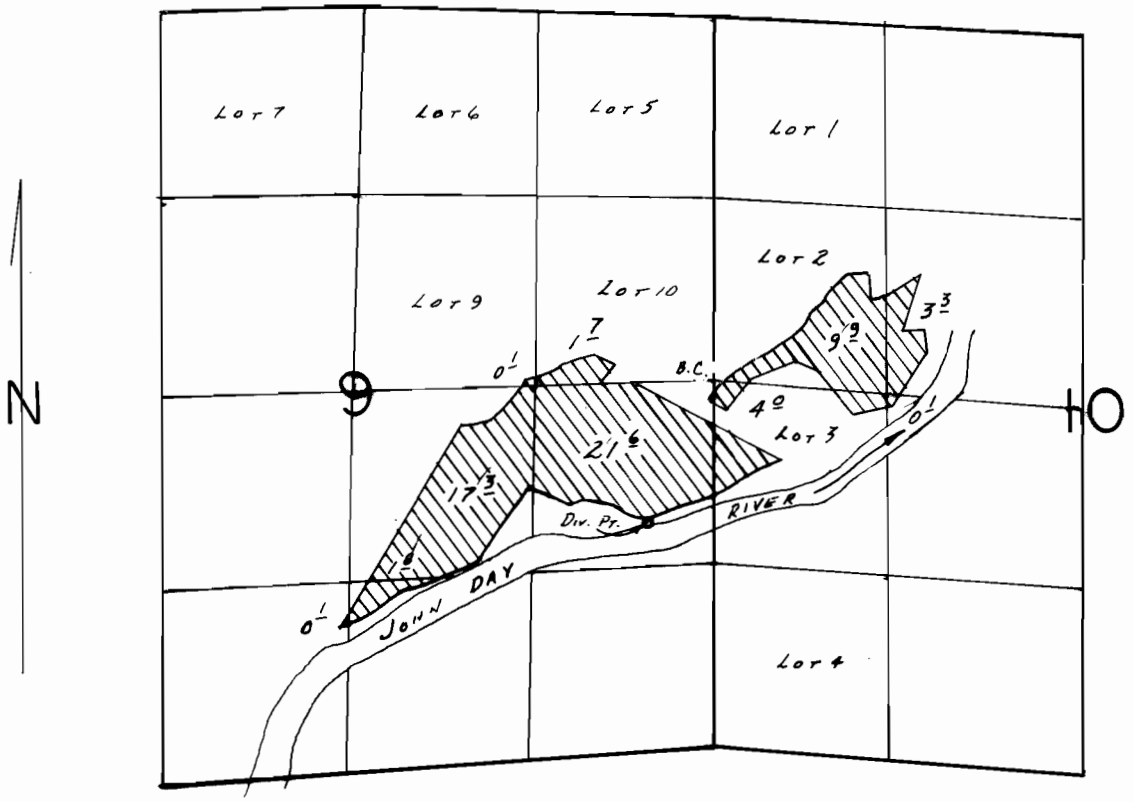

Div. Pt. Loc.: 960'S. & 450'W. FROM E. 1/4 Cor. SEC. 9.

SCALE: 1" = 1320'

FINAL PROOF SURVEY

UNDER

Application No. 59783 **Permit No.** 45364

IN NAME OF

H. KELLY McGREER

Surveyed Aug. 11 **19** 88, **by** B. W. BISHOP

11/3/89 RWB

PTS 11-1988