


T. 29 S., R. 5 W., W. M.

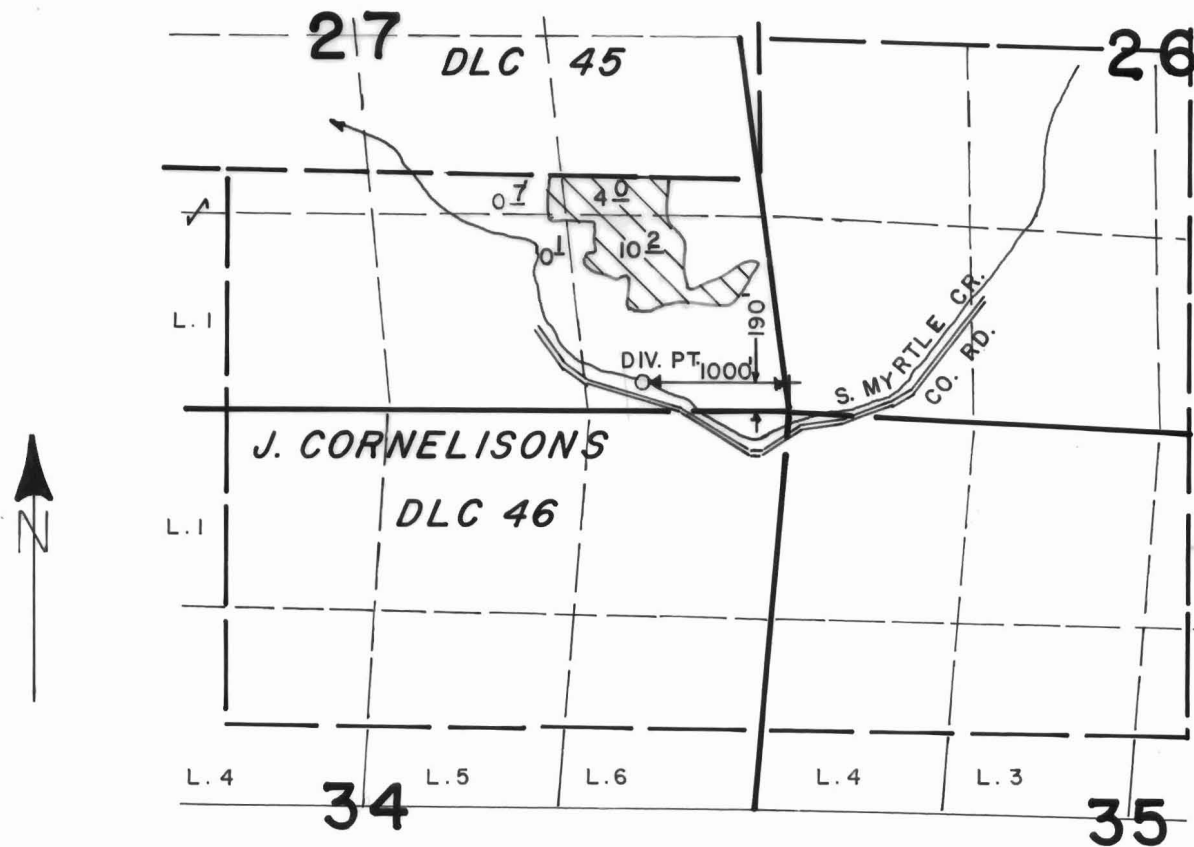

SCALE: 4" = 1 MILE

FINAL PROOF SURVEY UNDER

Application No. 60024 Permit No. 45073.....
IN NAME OF

.....KENNETH L. McFARLAND.....

Surveyed MAY 19 1986., by J.M. SCHMORDE