


T. 30S., R. 5 W., W.M.

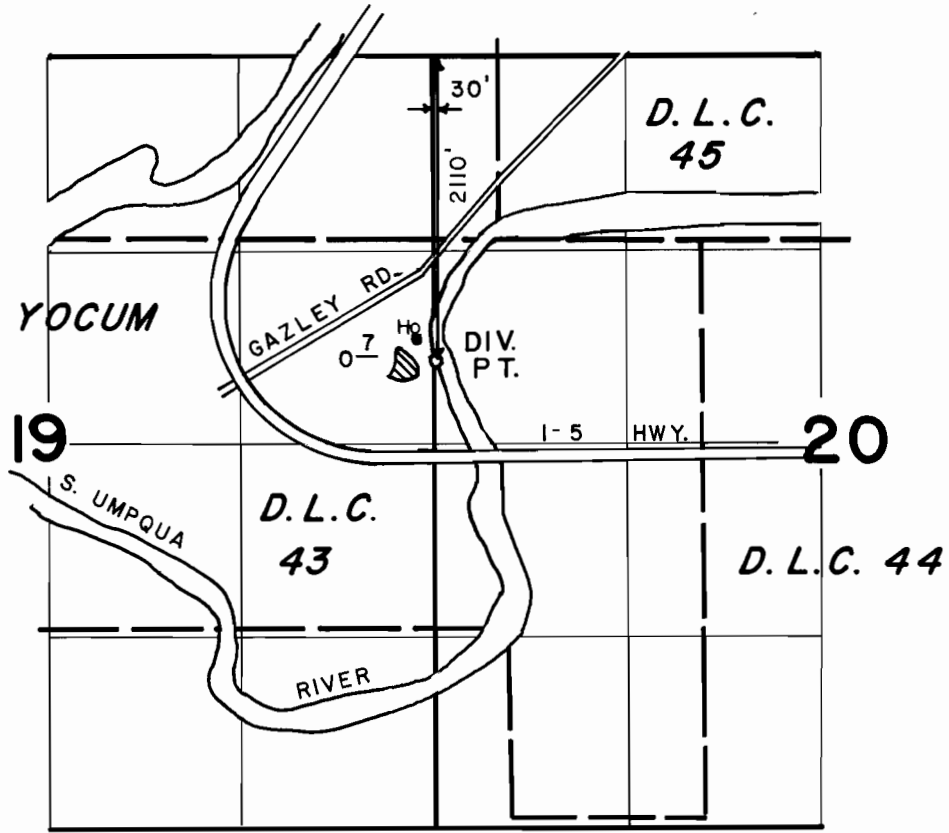

SCALE : 4 " = 1 MILE

FINAL PROOF SURVEY UNDER

Application No. 60153... Permit No. 44929....
IN NAME OF

GEORGE WESLEY THOMAS

Surveyed JUNE 19, 1984, by L. E. CASHION