


T. 26S., R. 2W., W. M.

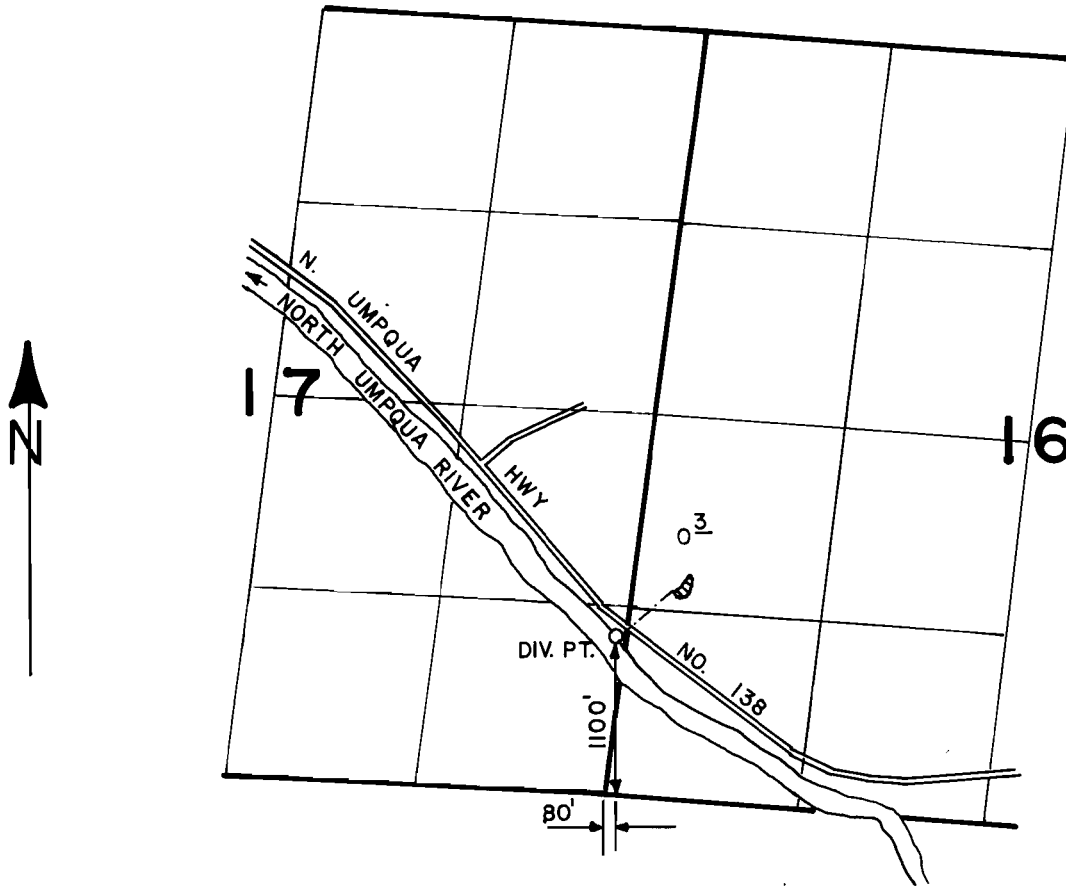

SCALE: 4" = 1 MILE

FINAL PROOF SURVEY
UNDER

Application No. 61257... Permit No. 45602...
IN NAME OF

HARRY J. COLLINS AND ARDETH U. COLLINS

Surveyed JULY 15, 1988, by J.M. SCHMORDE