


T. 37 S., R. 5 W., W.M.

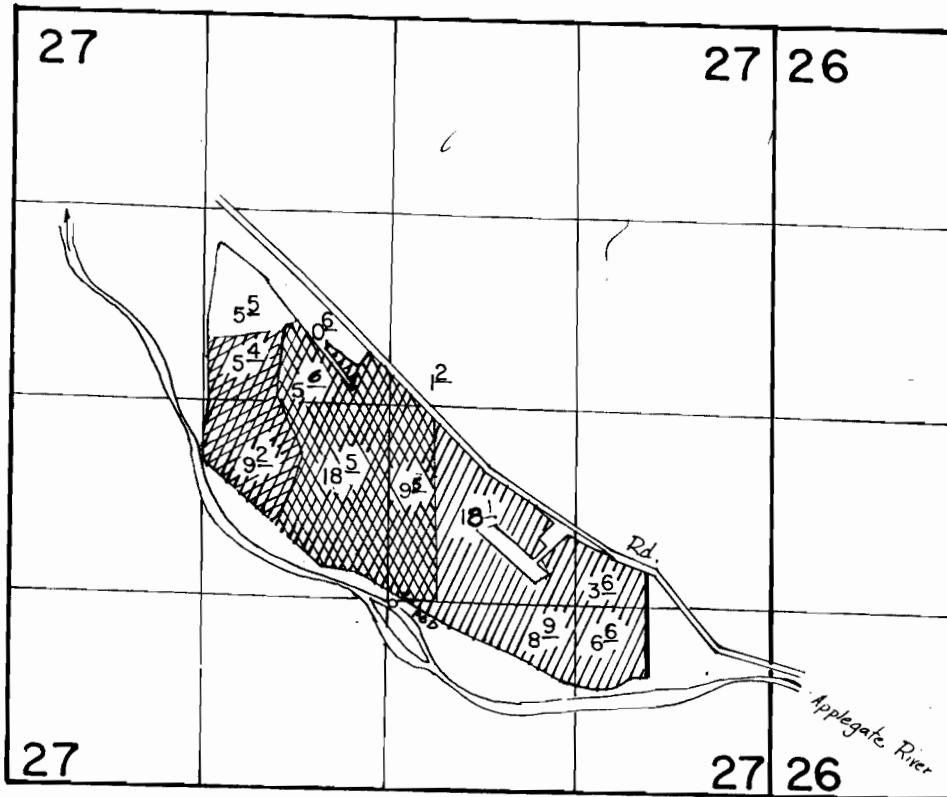

Div. Pt. located 50' S. & 50' E. from N.W. corner of
S.W. 1/4 SE. 1/4 Section 27.

FINAL PROOF SURVEY UNDER

TRANSFER NO. 3734

54190

40714

Application No. 62385.. Permit No. 46526.....



primary



supplemental



supplemental

IN NAME OF

ROBERT MILTON & RECO HILL

Surveyed JULY 27, 1982., by B. R. SUND.....