


T.11S., R.40E., W. M.

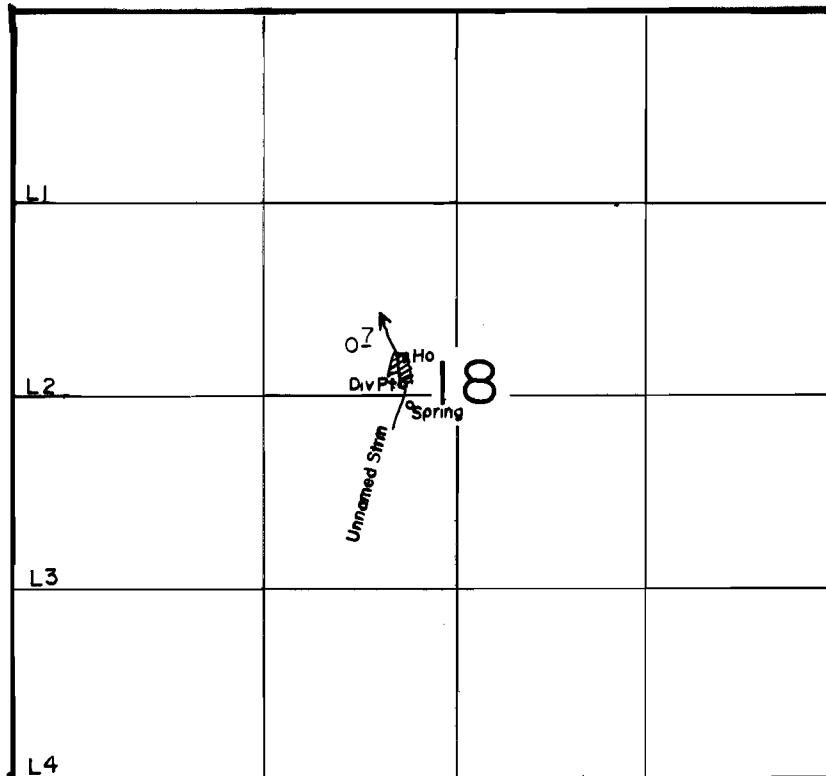

Spring Loc 60' S & 320' W., Div Pt. Loc 60' N. & 350' W Both From Center Of Sec 18

SCALE: 1" = 1320'

FINAL PROOF SURVEY UNDER

Application No. 67999.. Permit No. 48459.....
IN NAME OF

CARL E. HILBERG & JANICE K. NAUMAN

Surveyed JAN. 22. 1990., by V.L. CHURCH.....