


T. 23S., R. 5 W., W. M.

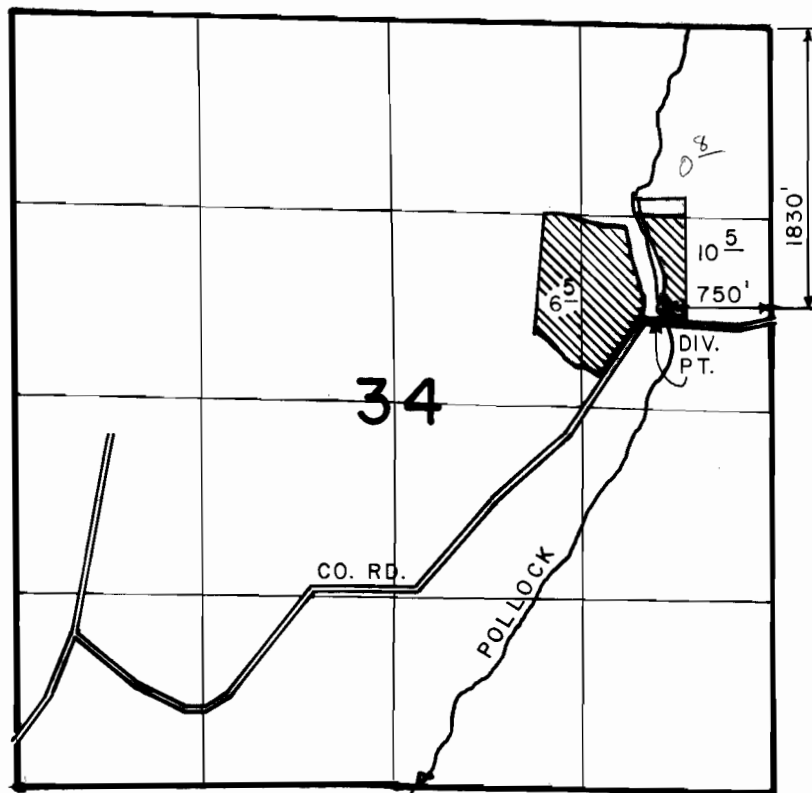

SCALE: 4" = 1 MILE

FINAL PROOF SURVEY
UNDER

Application No. 68386 Permit No. 49392
IN NAME OF

TODD M. FINK

Surveyed AUG. 18, 1988, by J. M. SCHMORDE