


T. 11 S., R. 40 E., W.M.

DEC 17 1988

9-17-88

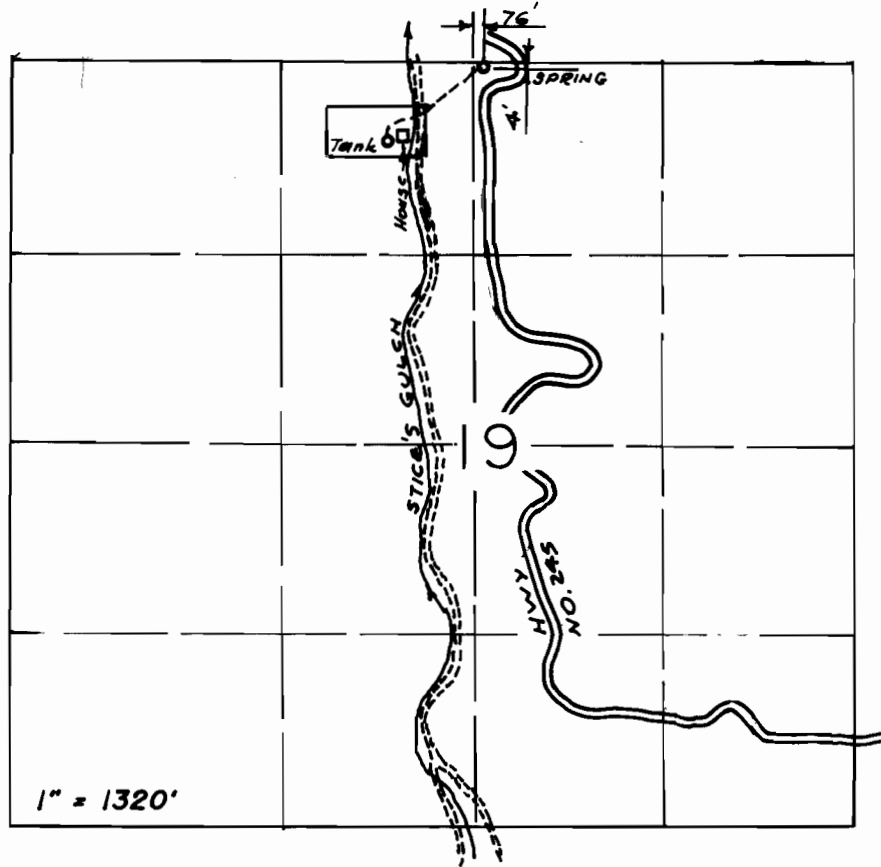

FINAL PROOF SURVEY

UNDER

Application No. 70076 Permit No. 50808

IN NAME OF

ARTHUR DEPAEPE

Surveyed SEPTEMBER 5, 1990

