


T. 9S., R. 40E., W. M.

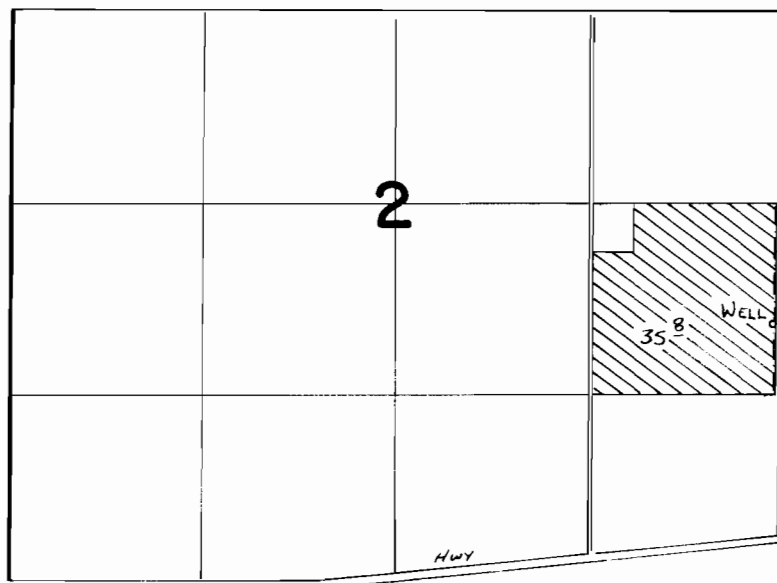

WELL Loc: 830' S. & 2600' E. FROM CENTER COR. SEC. 2

FINAL PROOF SURVEY
UNDER

SCALE: 1" = 1320'

Application No. **G:10972** Permit No. **G:10103**...
IN NAME OF

HOWARD LOGSDON

Surveyed *July 30* 19*84*, by *V.L. Church*.....