


T.12S. R.12E. WM.

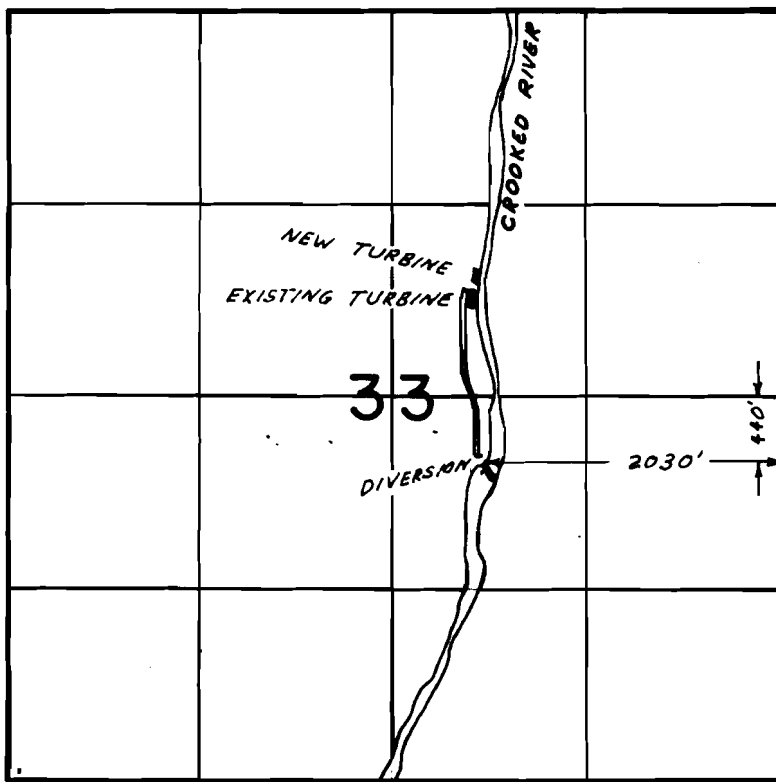

**FINAL PROOF SURVEY**  
UNDER

*Cert. # 65840*

Application No. 56774.. Permit No. 43521.....  
IN NAME OF

**DESCHUTES VALLEY WATER DISTRICT**

Surveyed APR...1... 1980., by L.H.NUNN.....

*Rec'd 7-24-91 WDA#4*

43521