


T. 24 S., R. 7 W., W. M.

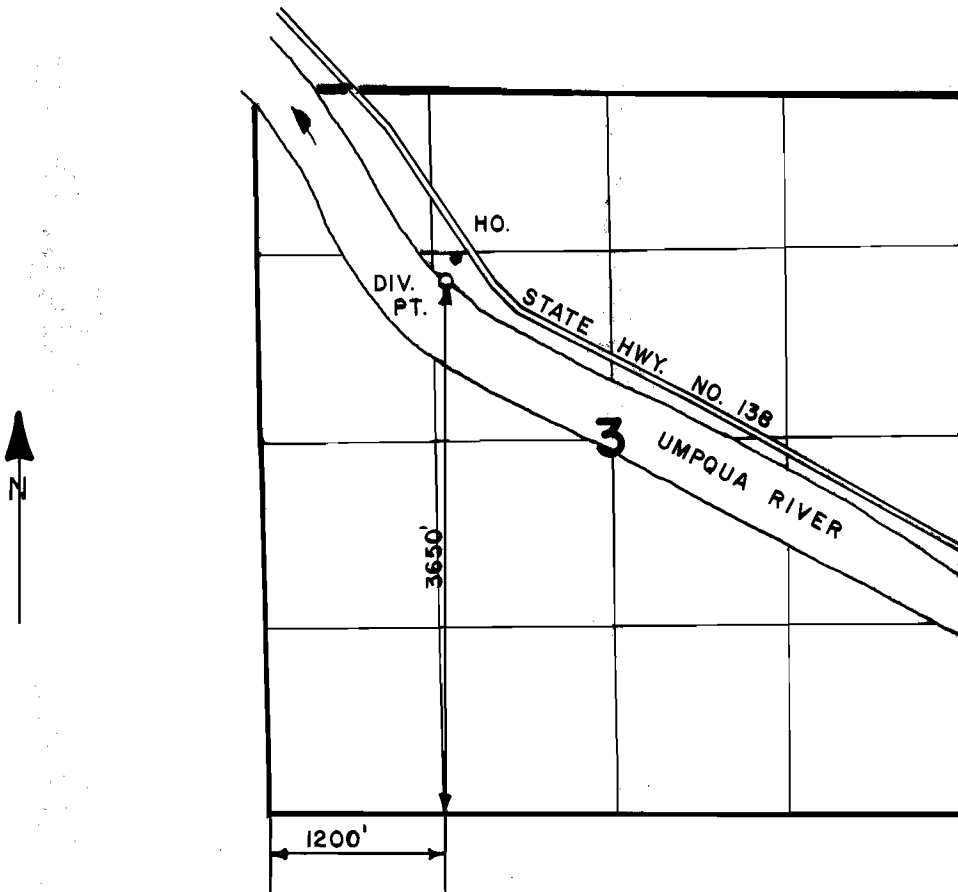

SCALE: 4" = 1 MILE

FINAL PROOF SURVEY
UNDER

Application No. 57039... Permit No. 42744.....
IN NAME OF

.....**LAWRENCE L. WOODWARD**.....

Surveyed AUG. 14... 1986., by J. M. SCHMORDE..