


T. 30 S., R. 2 W., W. M.

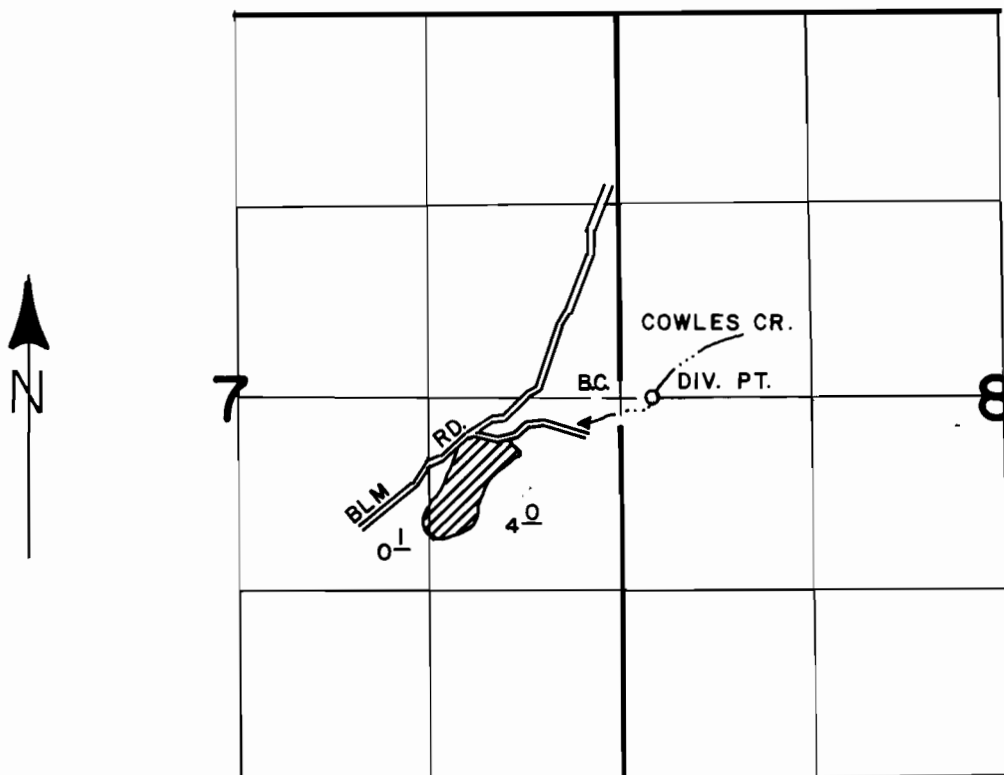

DIVERSION POINT IS 10 FEET NORTH AND 210 FEET EAST FROM W. 1/4 COR. SEC. 8.

SCALE: 4" = 1 MILE

FINAL PROOF SURVEY UNDER

Application No. 58180..... Permit No. 44777.....
IN NAME OF

NANCY E. GUTH.....

Surveyed AUG. 4..... 1987, by J. M. SCHMORDE.....