


T.40S., R.14W., W.M.

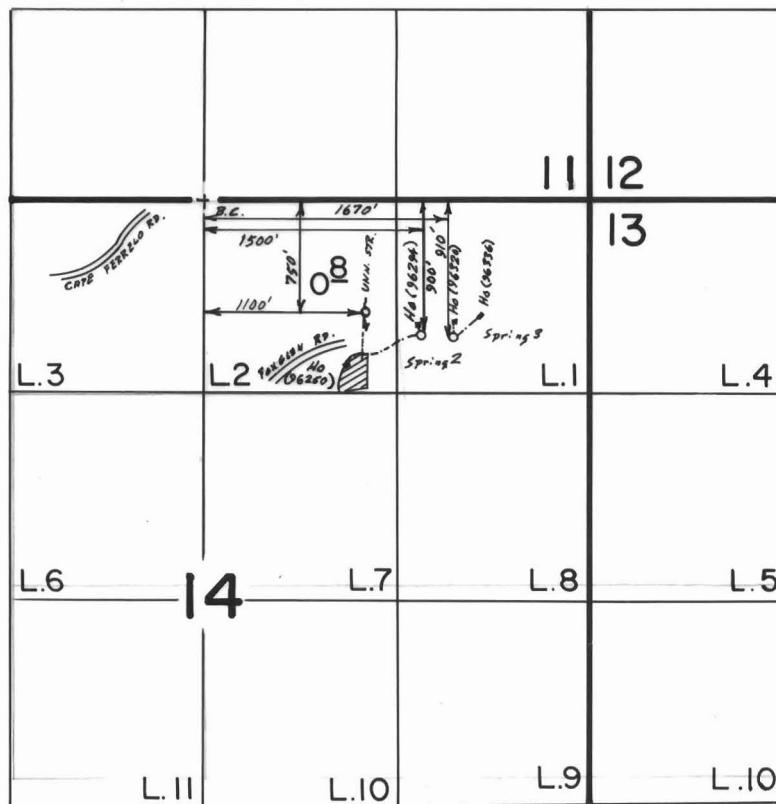

Scale 1" = 1320'



FINAL PROOF SURVEY UNDER

Application No. 60058. Permit No. 45722.....
IN NAME OF

EARL D. EDDY.....

Surveyed Sept. 30, 1987, by B.S. JAMES.....