


# T.28S., R.14W., W.M.

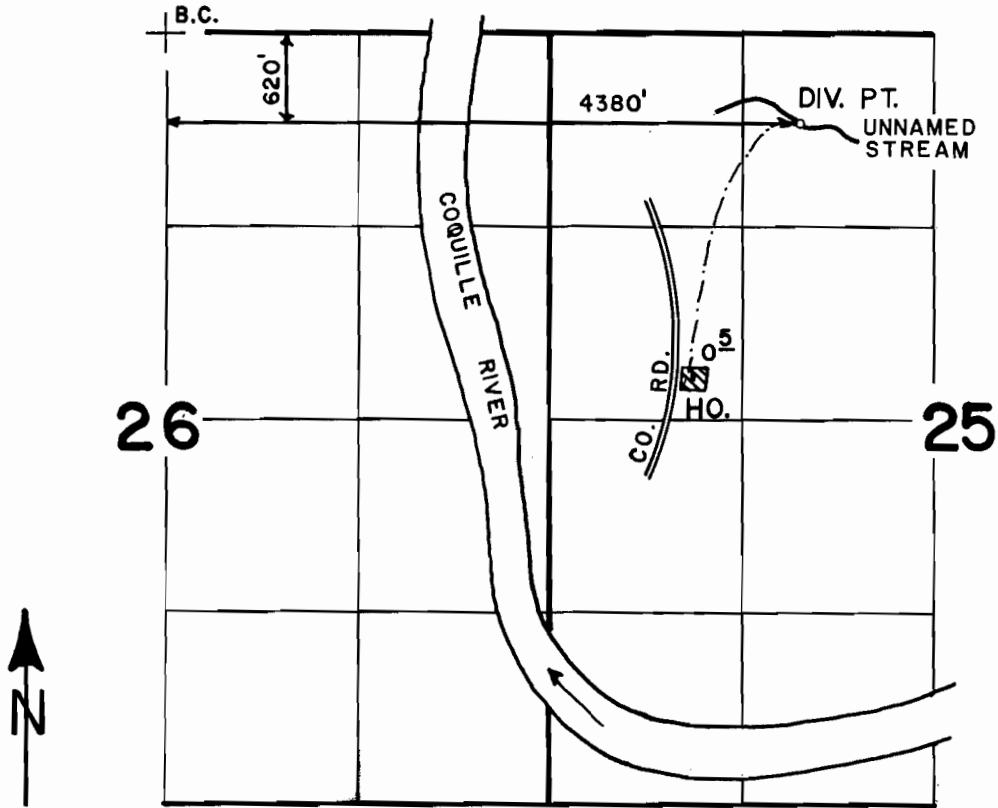

SCALE: 4" = 1 MILE

## FINAL PROOF SURVEY UNDER

Application No. 61186..... Permit No. 45550.....  
IN NAME OF

**SHERRY WALL**

Surveyed JUNE 11, 1986, by J. M. SCHMORDE