


# T.1S., R.13E., W.M.

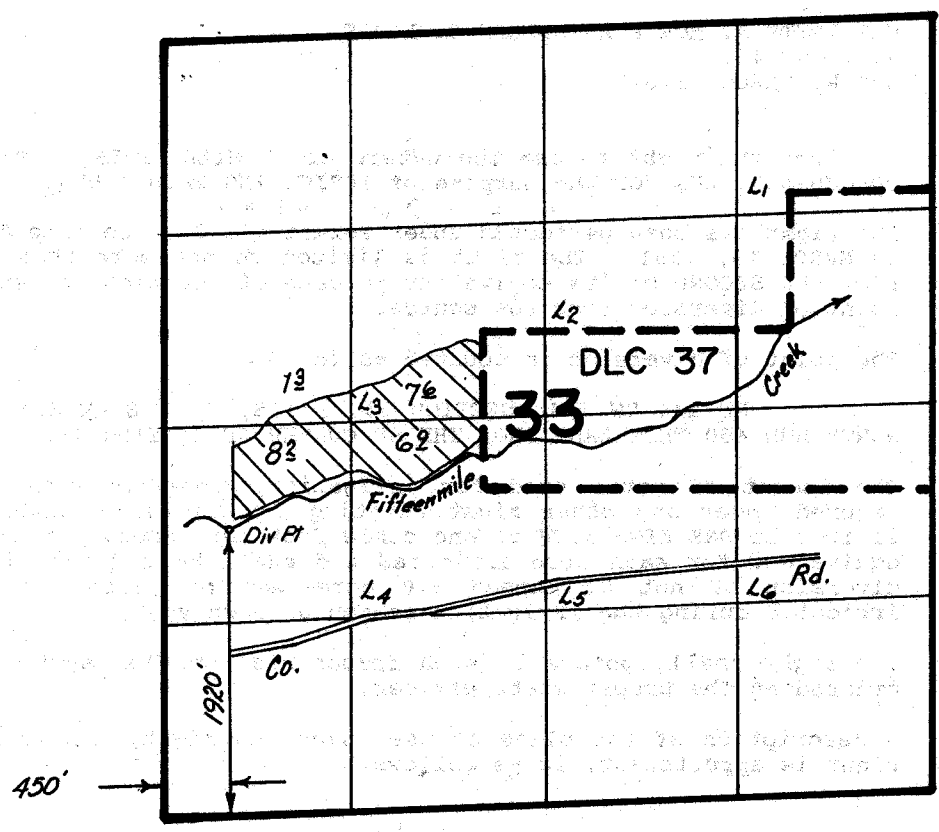

Scale: 1" = 1320'

## FINAL PROOF SURVEY UNDER

Application No. 61355 Permit No. 45673  
IN NAME OF

HARRIETTE A. MOE & KATHYLEEN D. LARIE

Surveyed 8-10 1987, by Vern Church