


T.3S., R.40E., W.M.

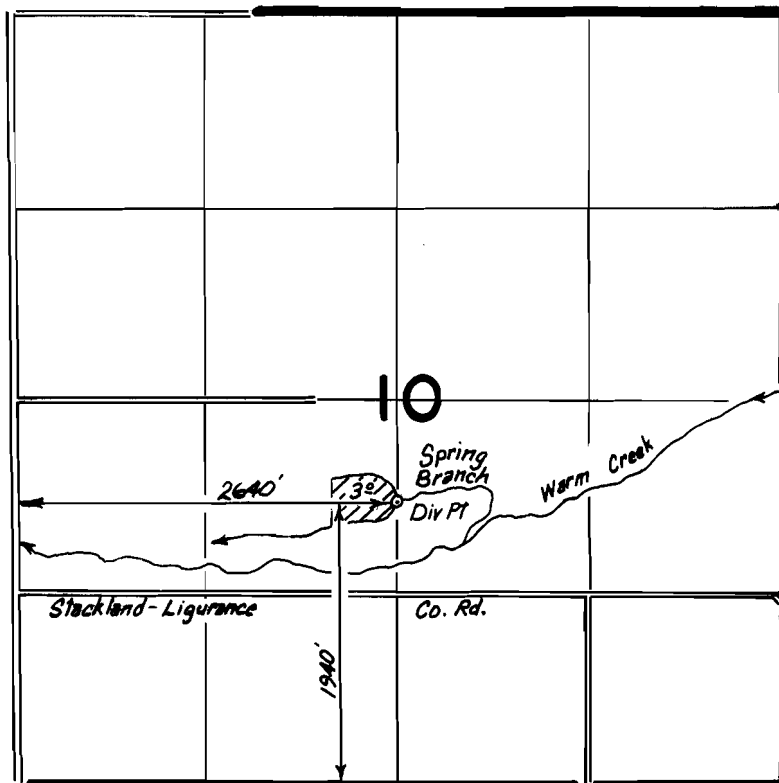

Scale: 1" = 1320'

FINAL PROOF SURVEY
UNDER

Application No. **61445** Permit No. **45751**.....
IN NAME OF

LEONARD L FOLTZ & VIOLET K FOLTZ.....

Surveyed **4-14**..... 19**87**., by **Vern Church**.....