


T. 26 S., R. 5 W., W.M.

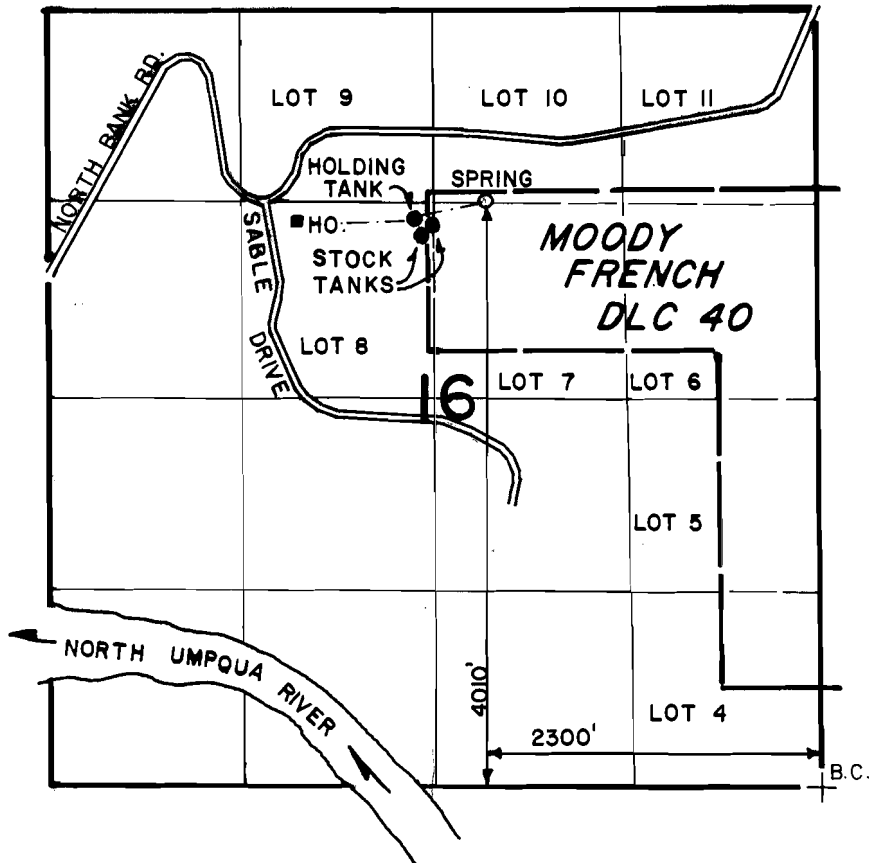

SCALE : 4" = 1 MILE

FINAL PROOF SURVEY
UNDER

Application No. 61523..... Permit No. 45692.....
IN NAME OF

.....CARLOS S. SHORT.....

Surveyed OCT. 9..... 1986., by J.M. SCHMORDE.