


T. 25 S., R. 5 W., W.M.

SECTION 17

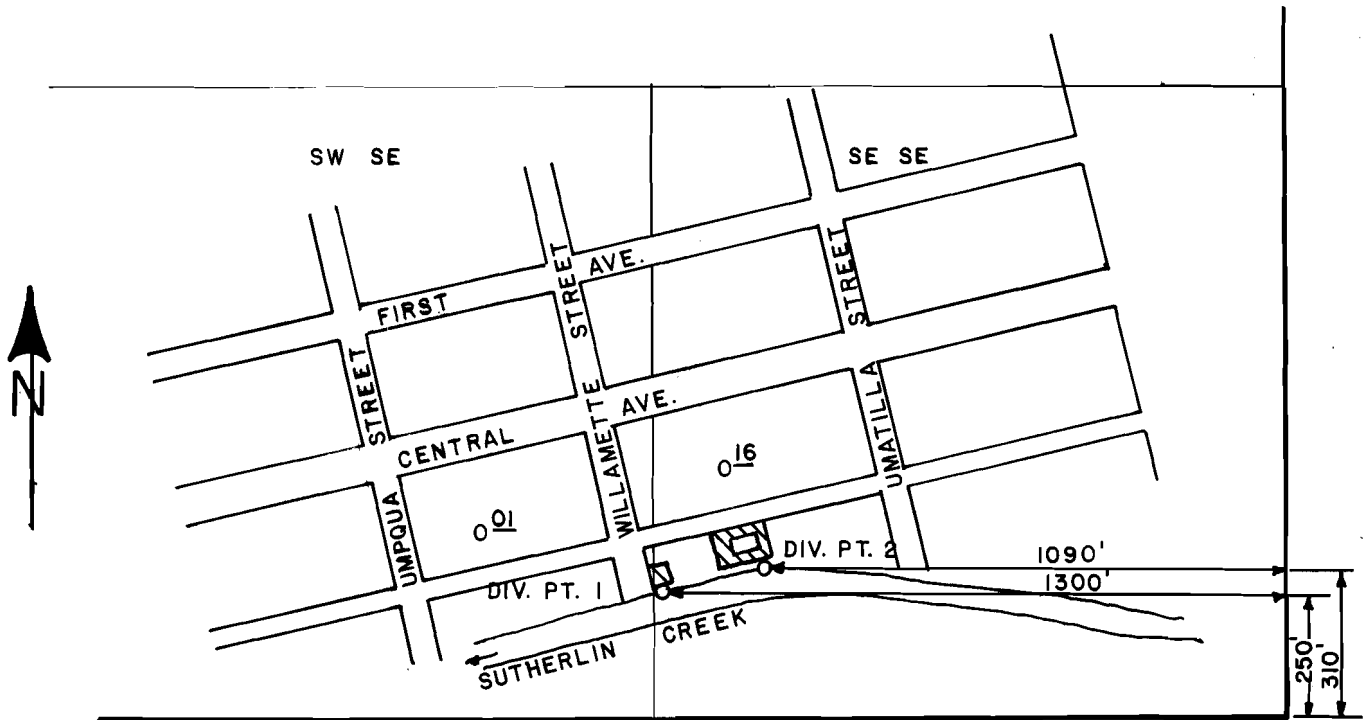

SCALE: 1" = 400'

FINAL PROOF SURVEY
UNDER

Application No. 61536..... Permit No. 45694.....
IN NAME OF

HELEN R. WARD OR WARREN D. WARD AND TRACY J. AND/OR GAIL A. WARD

Surveyed JULY 2..... 1986., by J.M. SCHMORDE