


T. 28 & 29 S., R. 6 W., W. M.

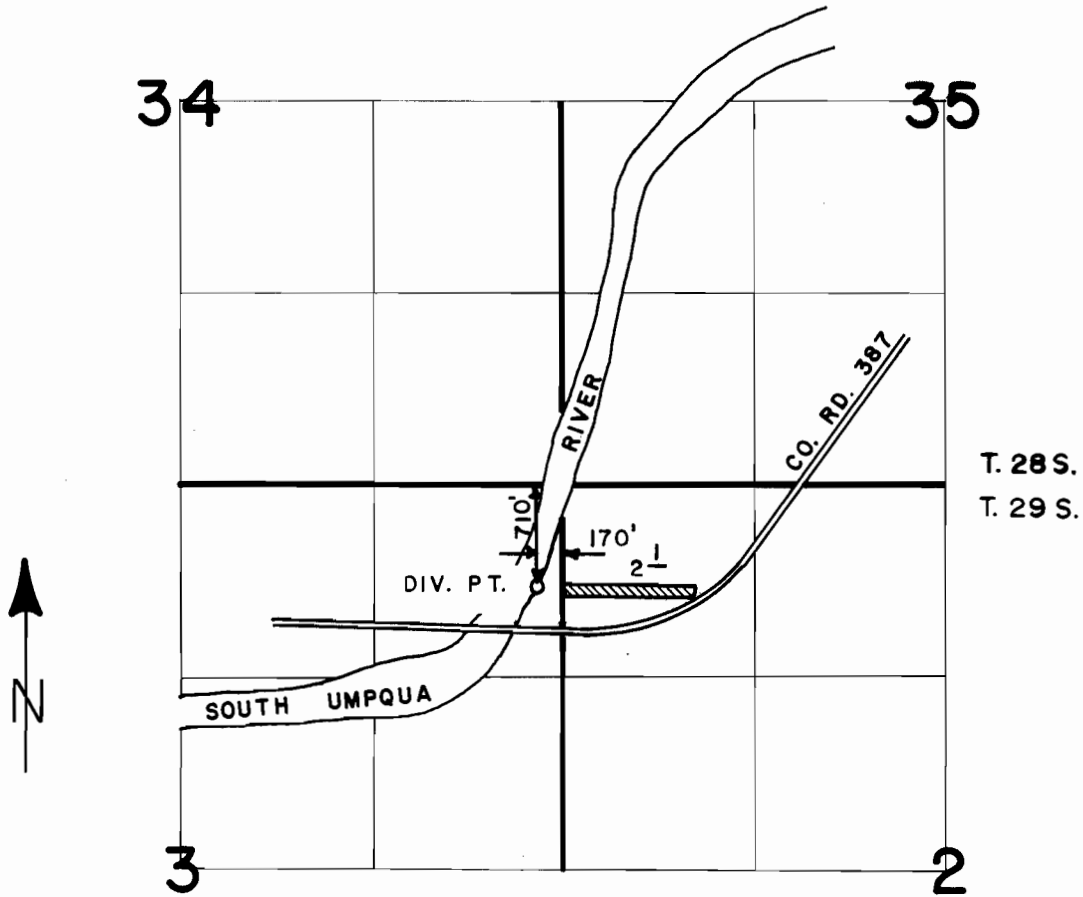

SCALE: 4" = 1 MILE

FINAL PROOF SURVEY
UNDER

Application No. 62402 Permit No. 46520
IN NAME OF

NORMAN PHILLIPS

Surveyed JUNE 29 1987, by J. M. SCHMORDE