


T. 30 S., R. 5 W., W.M.

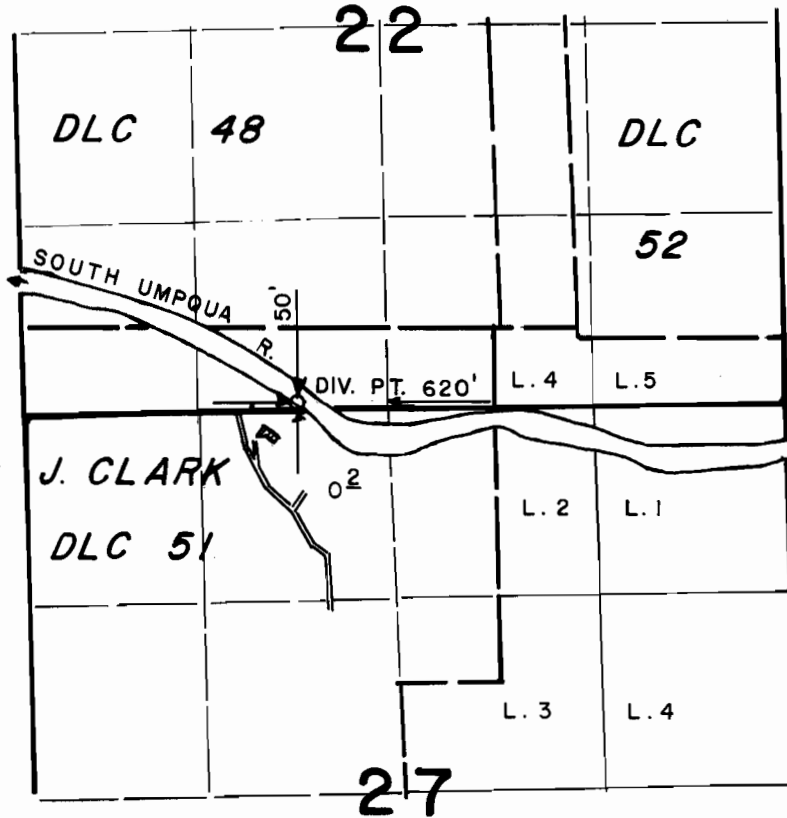

SCALE: 4" = 1 MILE

FINAL PROOF SURVEY
UNDER

Application No. 63539... Permit No. 46831.....
IN NAME OF

ORAL JONES

Surveyed APRIL 22 1987., by J.M. SCHMORDE