


T.27S., R.5W., W.M.

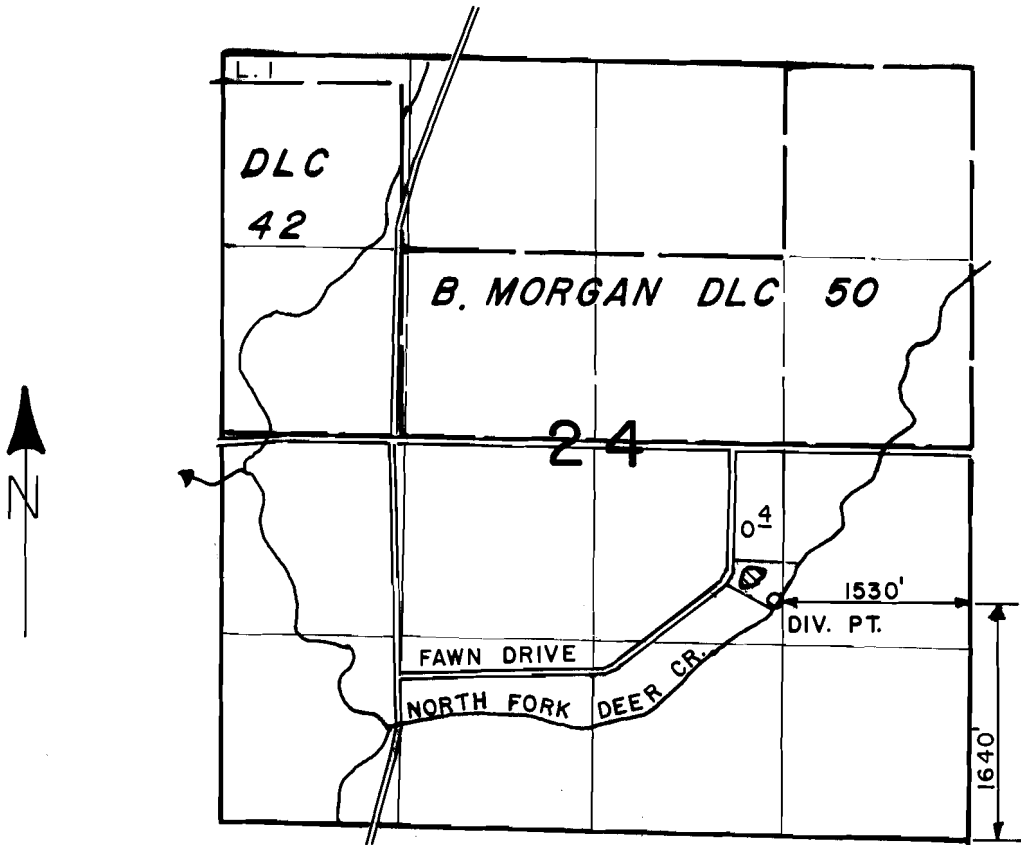

SCALE: 4" = 1 MILE

FINAL PROOF SURVEY
UNDER

Application No. 63688... Permit No. 46876.....
IN NAME OF

GARY L. LEWIS

Surveyed OCT. 26... 1987., by J. M. SCHMORDE