


# T.32 S., R.5 W., W.M. SECTION 35

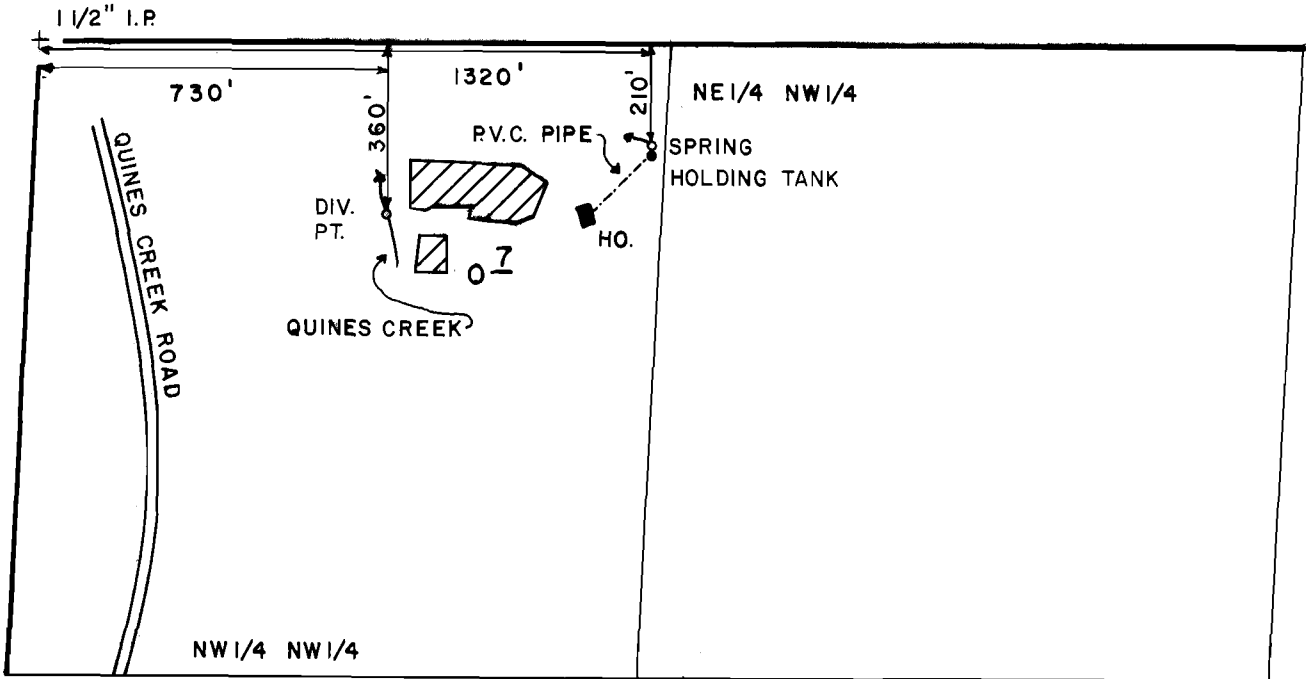

SCALE: 1" = 400'

## FINAL PROOF SURVEY UNDER

Application No. 63796.. Permit No. 47311.....  
IN NAME OF

**RALPH W. GIFFIN**

Surveyed AUG. 23. 1984, by L. E. CASHION.