


T. 18 S., R. 11 W. WM.

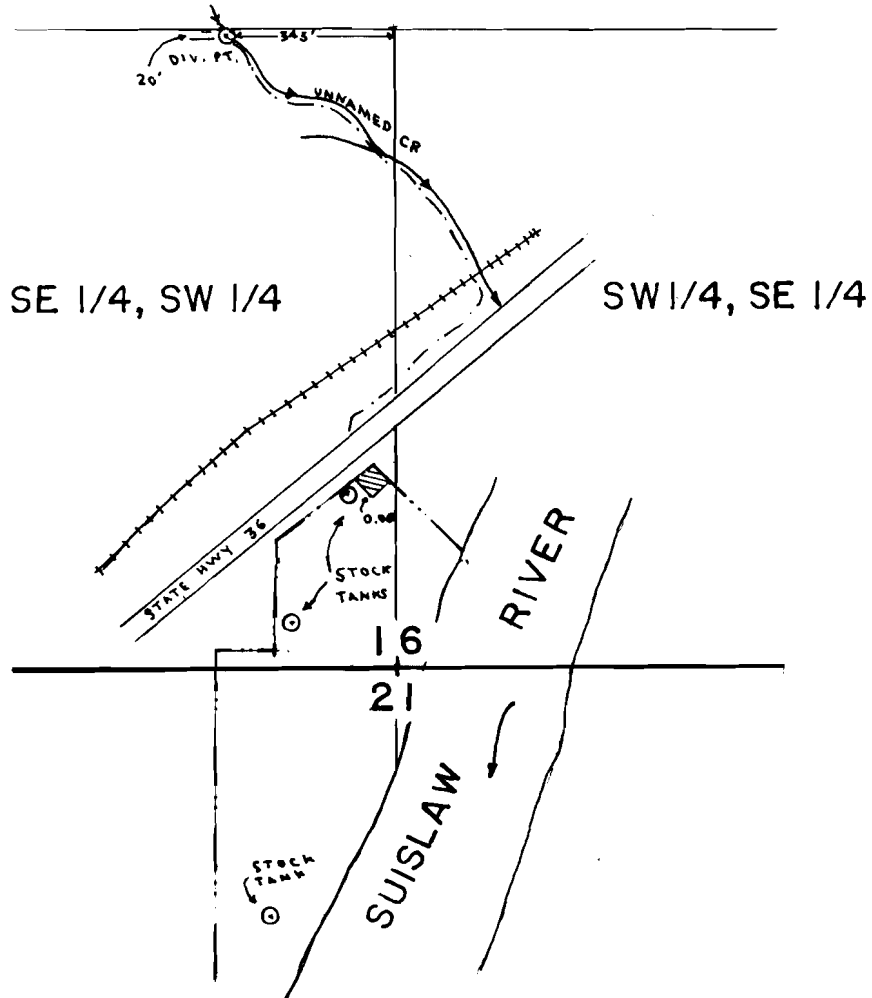

**FINAL PROOF SURVEY**  
UNDER

Application No. 64157 Permit No. 47159  
IN NAME OF

HONG-SHIOU CHIOU

Surveyed NOV. 1, 1983, by P. PAGTER