


T. 26 S., R. 4 W., W.M.

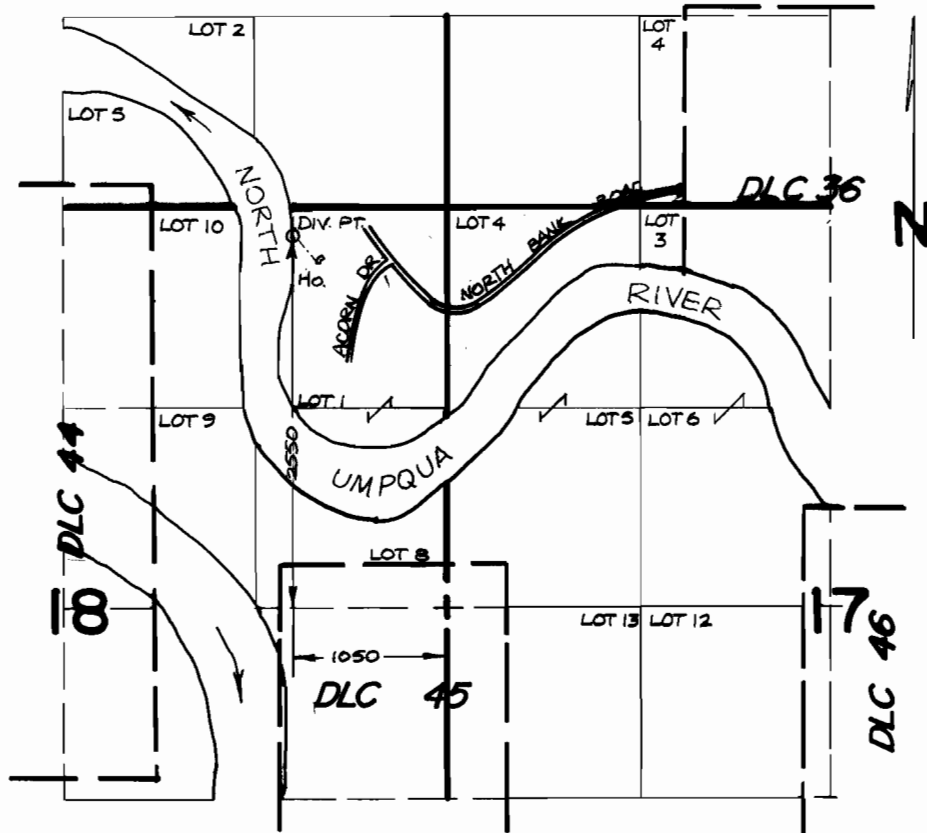

SCALE : 4" = 1 MILE

FINAL PROOF SURVEY UNDER

Application No. ...6450! Permit No. ...47179.....
IN NAME OF

.....LEONARD W. RILEY III.....

Surveyed ..SEPT..8, 19.86., by ...J.M..SCHMORDE