


P-47287
C-65861

T. 13S., R. 25E., W. M.

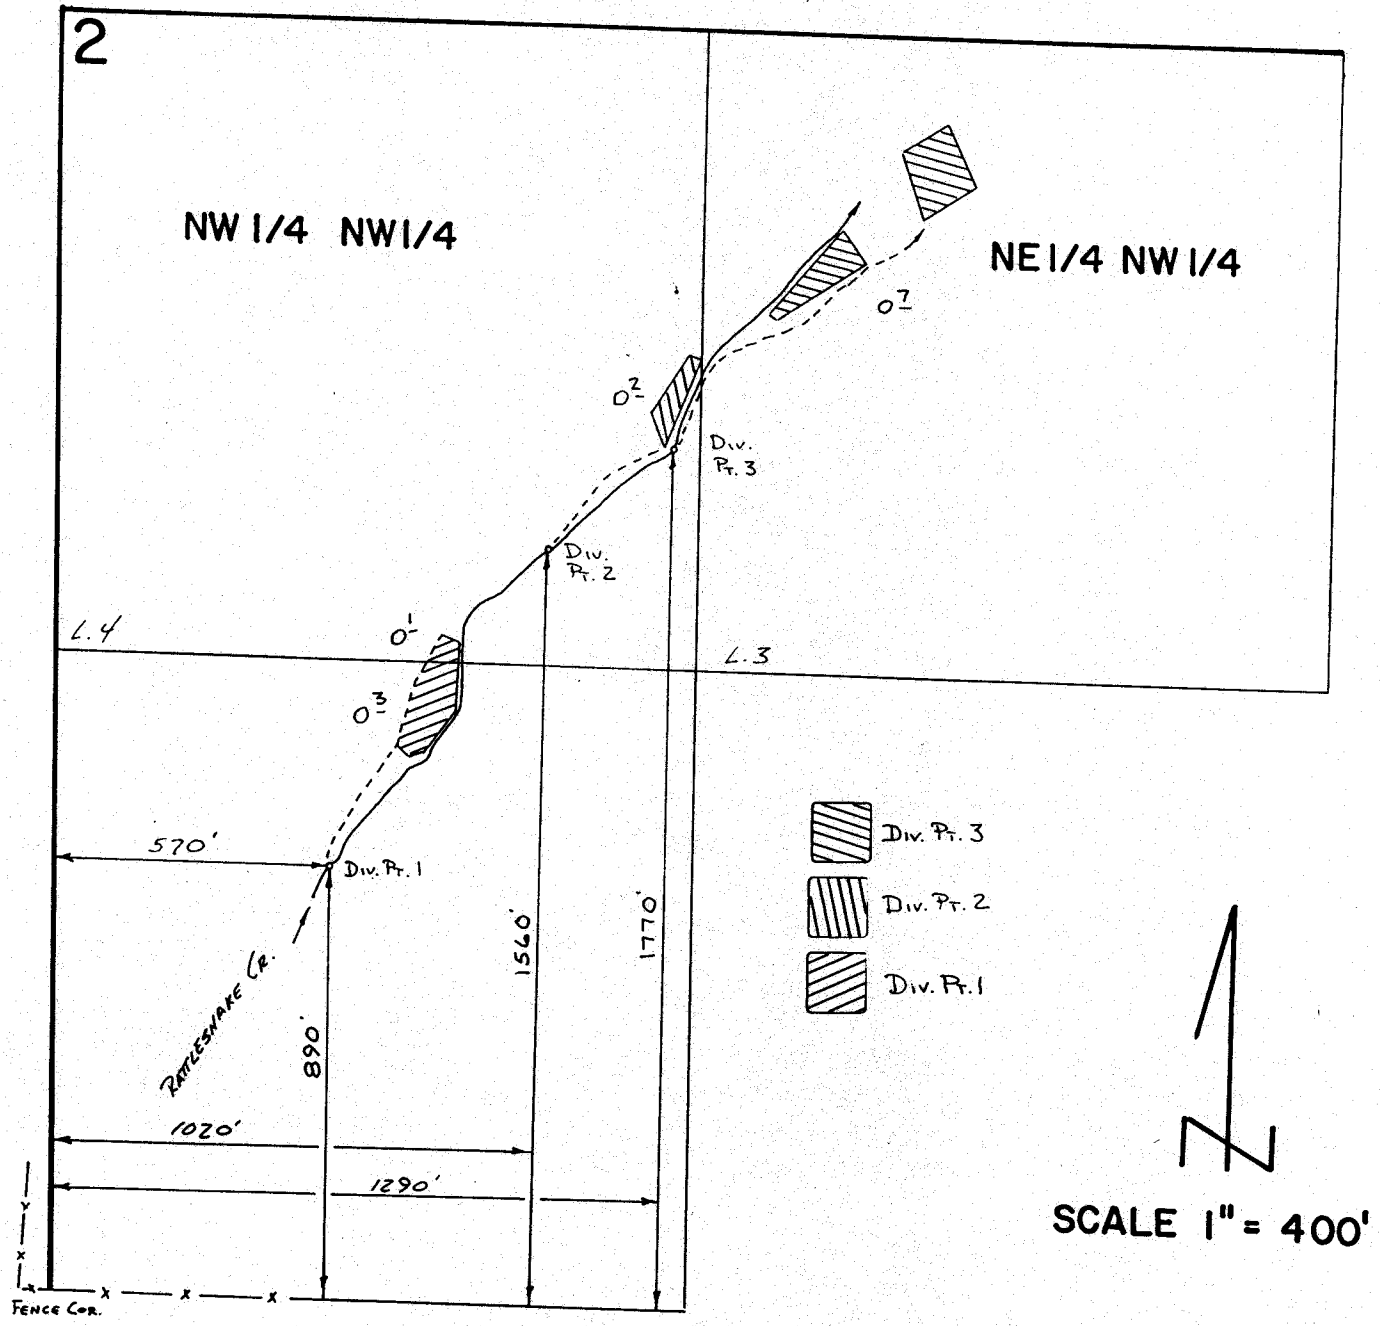

FINAL PROOF SURVEY
UNDER

Application No. **64536** Permit No. **47287**
IN NAME OF

WARREN PANCAKE

Surveyed **5-11** 19**87**, by **K.H. Church**