


TIOS, RIOW, WM

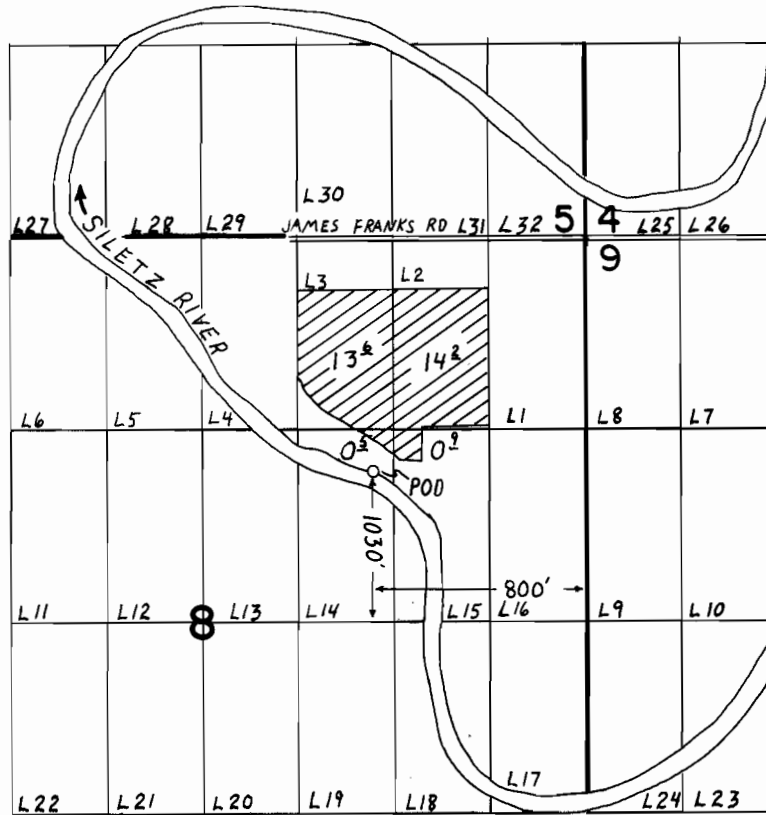

FINAL PROOF SURVEY UNDER

Application No. 6.5.0.6.4 Permit No. 4.7.7.9.9...
IN NAME OF

.....WALLACE HIGH.....

Surveyed NOV. 3. 1987., by T. M. WARREN...