
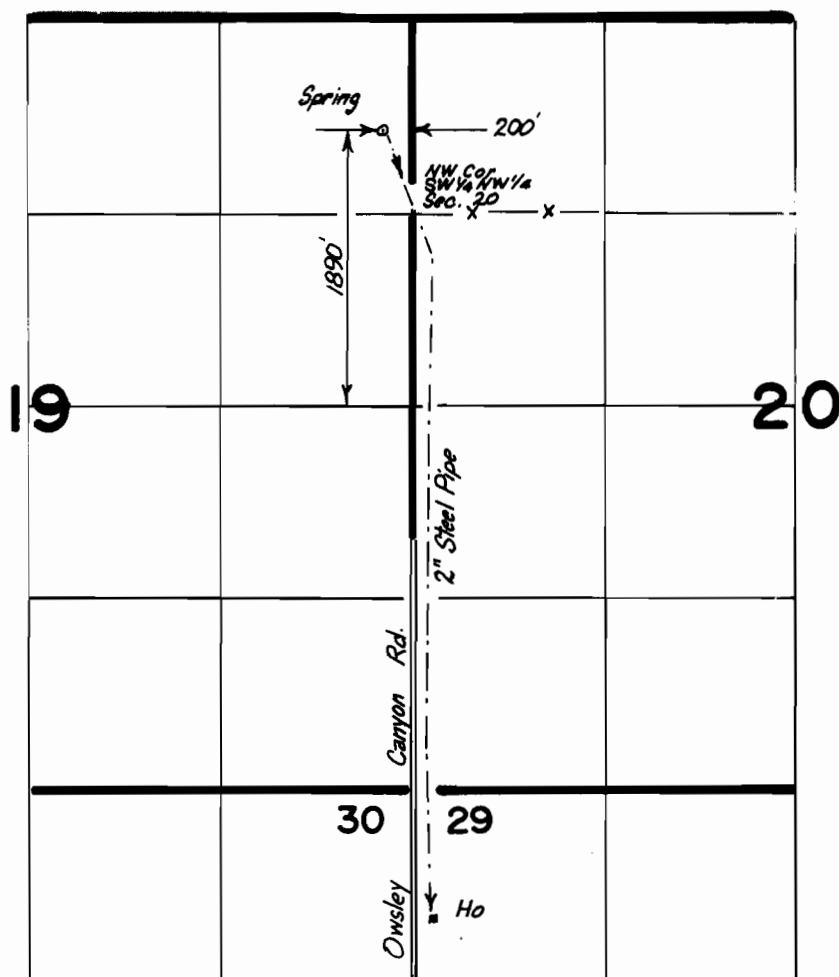


T.2S., R.38E., W.M.

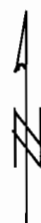

FINAL PROOF SURVEY UNDER


Scale: 1" = 1320'

Application No. **65090** Permit No. **47813**
IN NAME OF

DONALD F. & A. DIANNA SHAW

Surveyed 5-5 1987, by Vern Church