


T. 5 S., R. 3 W., WM

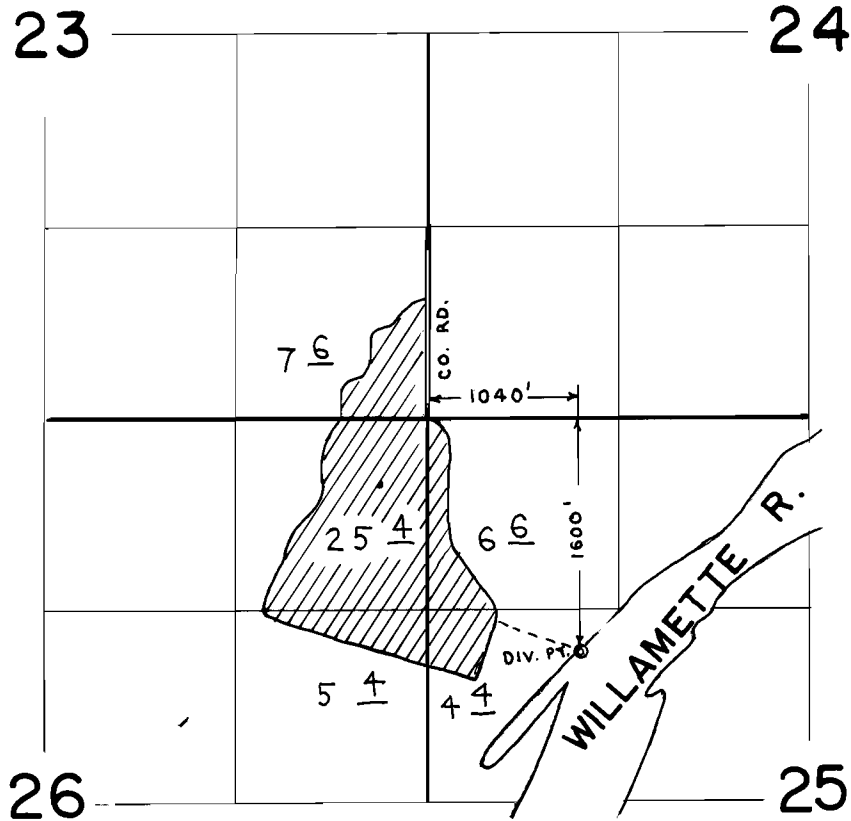

FINAL PROOF SURVEY UNDER

Application No. 65276... Permit No. 47677.....
IN NAME OF

.....JOHN NOBLE.....

Surveyed APR 27, 1984, by P. PAGTER.....