


T. 29 S., R. 6 W., W.M.

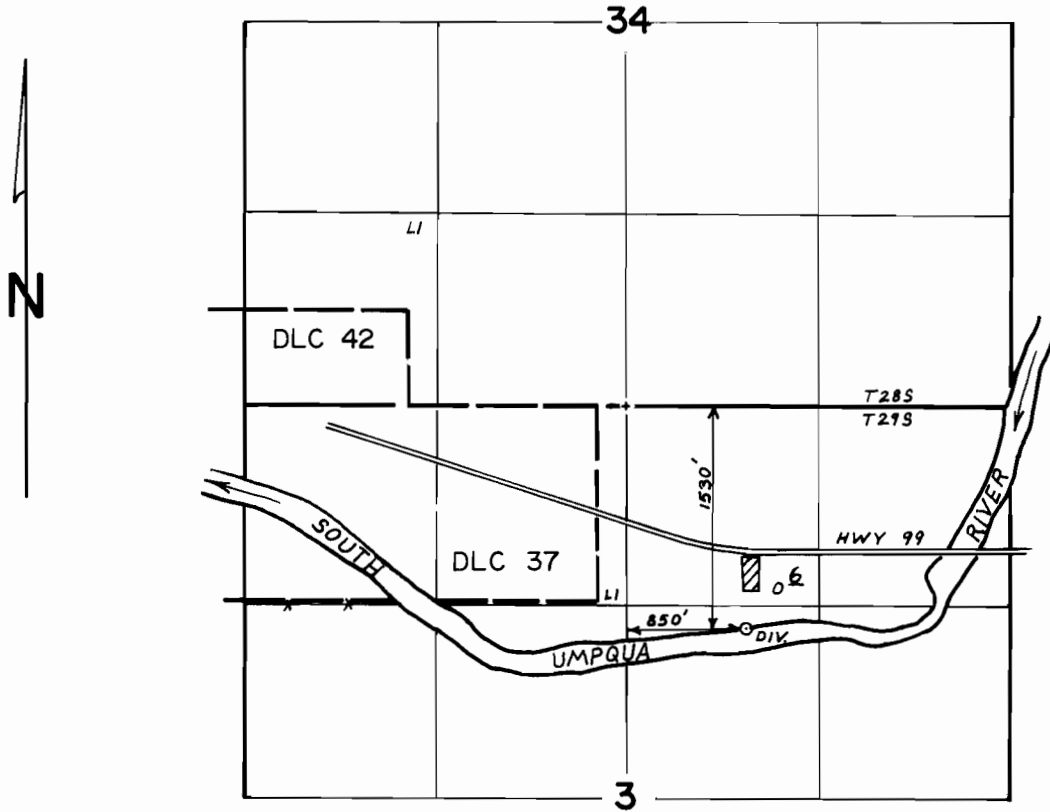

SCALE: 4" = 1 mile

**FINAL PROOF SURVEY**  
UNDER

Application No. 67926... Permit No. 48301.....  
IN NAME OF

**ROBERT JAMES & DIXIE LEE QUIROZ**

Surveyed JUN...27, 1984., by *L.E. Cashion*.....