


T.19S. R.11W., W.M.

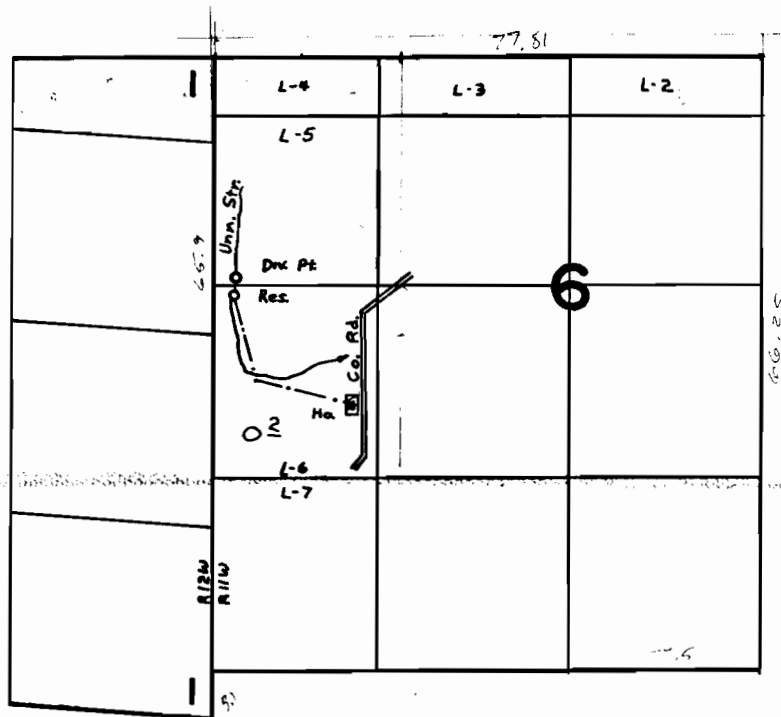

Div. Pt. Loc. 50' N. & 150' E. From W. 1/4 Cor. Sec. 6

Application No. 70427
Permit No.

FINAL PROOF SURVEY UNDER

Application No. 50612..... Permit No. 38247....
IN NAME OF

.....CLARK JOHNSON.....

Surveyed AUG. 26. 1977., by B.R. SUND.....