


T.9&10S.R.2W.W.M.

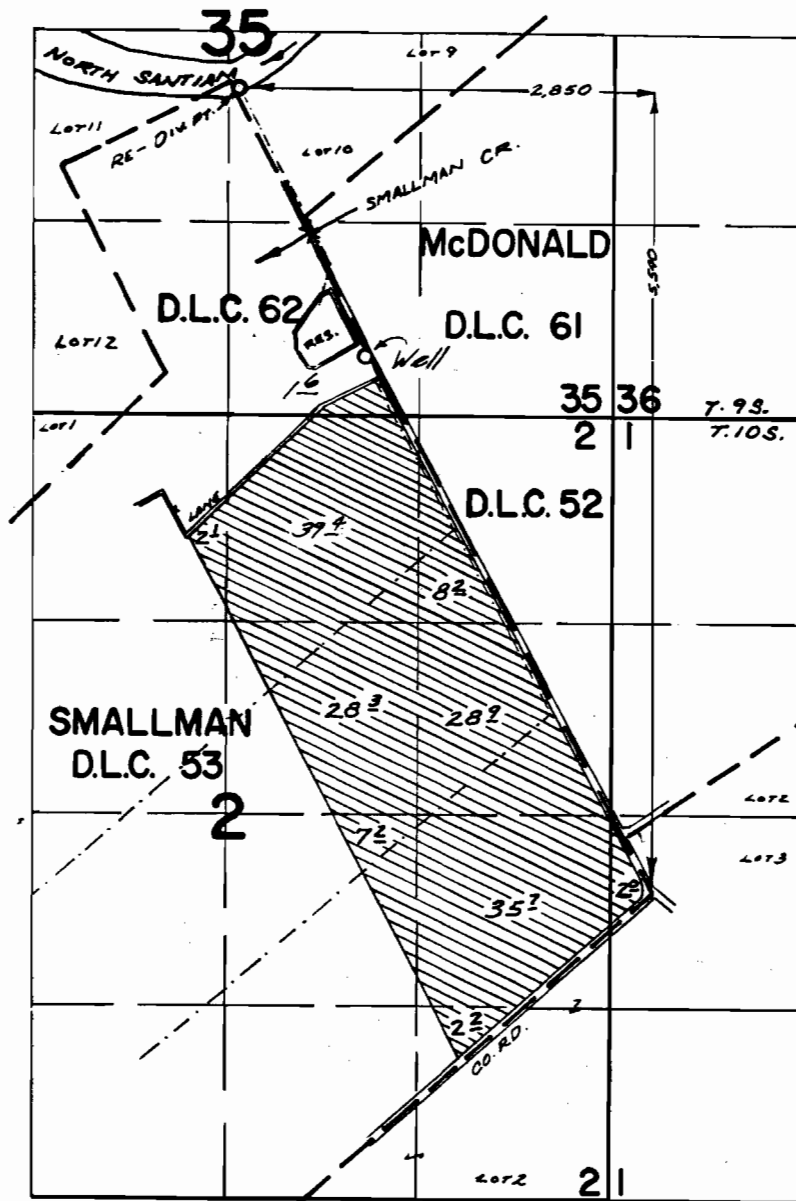

FINAL PROOF SURVEY

UNDER

Well Loc.: 3630' N & 1970' W from
the SE Easly Cor D.L.C. 53

Application No. 3-7999 Permit No. 4-7440
IN NAME OF

Walter D. Miller

Surveyed July 3, 1979, by J.C. Brown