


# T.36S., R.3W., W.M.

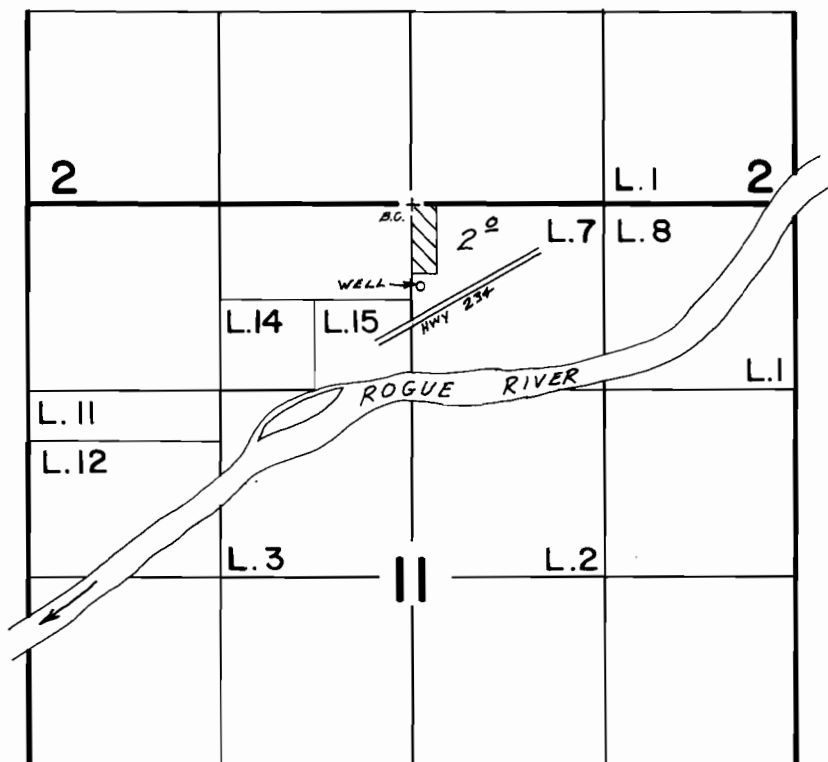

WELL: 550'S & 60'E From N $\frac{1}{4}$  COR. SEC. 11.

Scale 1"=1320'

## FINAL PROOF SURVEY UNDER

Application No. G-9000 Permit No. G-8458...  
IN NAME OF

R. D. TUCKER

Surveyed July 9, 1987, by B.S. JAMES