


# T.4S., R.1E., W.M.

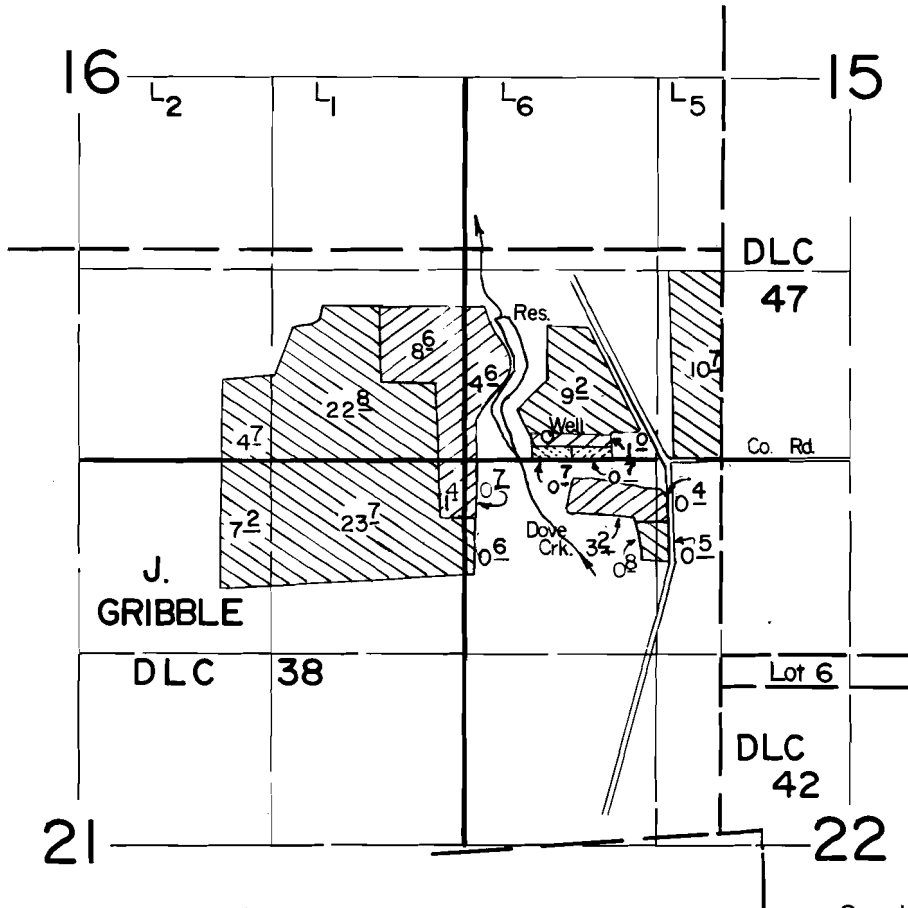

Scale: 1" = 1320'

Well Loc.: 1300' S. & 1180' W. from NE Cor.

J. Gribble DLC 38.


Supplemental Irrigation & Containerized Stock

Supplemental Irrigation & Greenhouse (Holding House Use)

Primary

Supplemental

Related Nursery Use

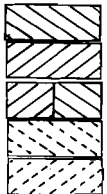

## FINAL PROOF SURVEY UNDER

Application No. G-9767 Permit No. G-9800....

IN NAME OF

### HOWARD J. SMITH, (FOUR MILE NURSERY)

Surveyed JULY...1... 1985., by T. Warren.....