


T.1S. R.13E. W.M.

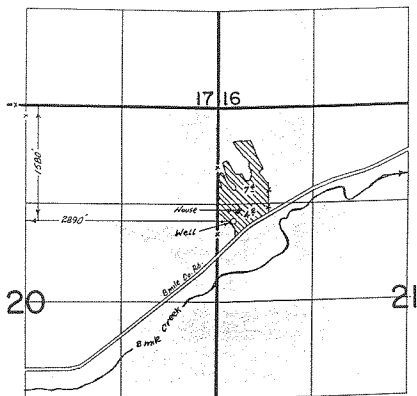

**FINAL PROOF SURVEY**  
UNDER

Application No. G-10345 Permit No. G-9573.  
IN NAME OF

..... CARL L. INGRAM .....

Surveyed May, 3, 1983, by T. J. Paul.....