


T. 36 S., R. 3 W., W. M.

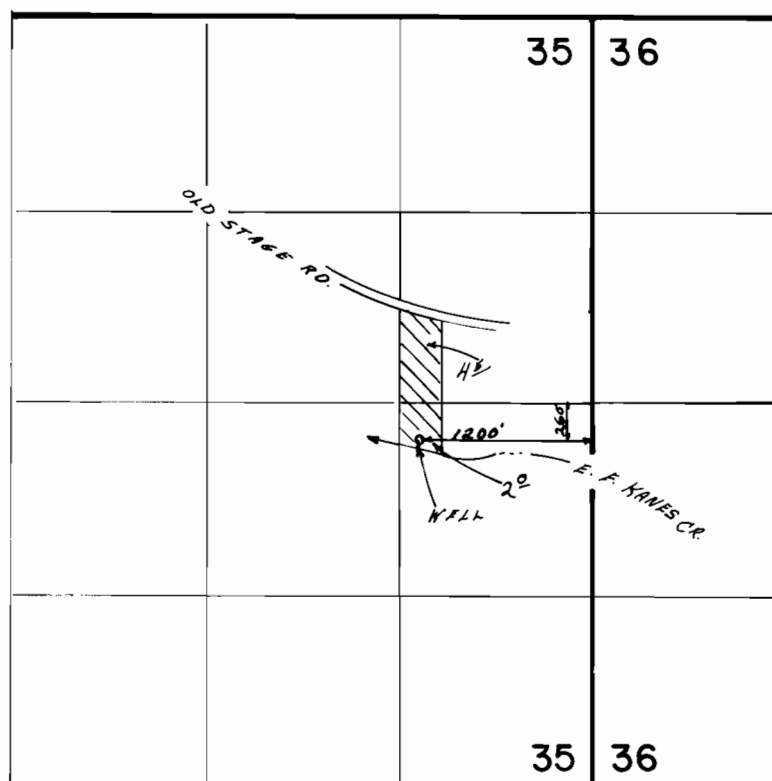

Scale: 1" = 1320'

**FINAL PROOF SURVEY**  
UNDER

Application No. G-10517 Permit No. G-9675  
IN NAME OF

...ROGER & DONNA ROBERTS...

Surveyed JUN. 25. 1986, by B.S. JAMES...