


T.7S., R.38E., W.M.

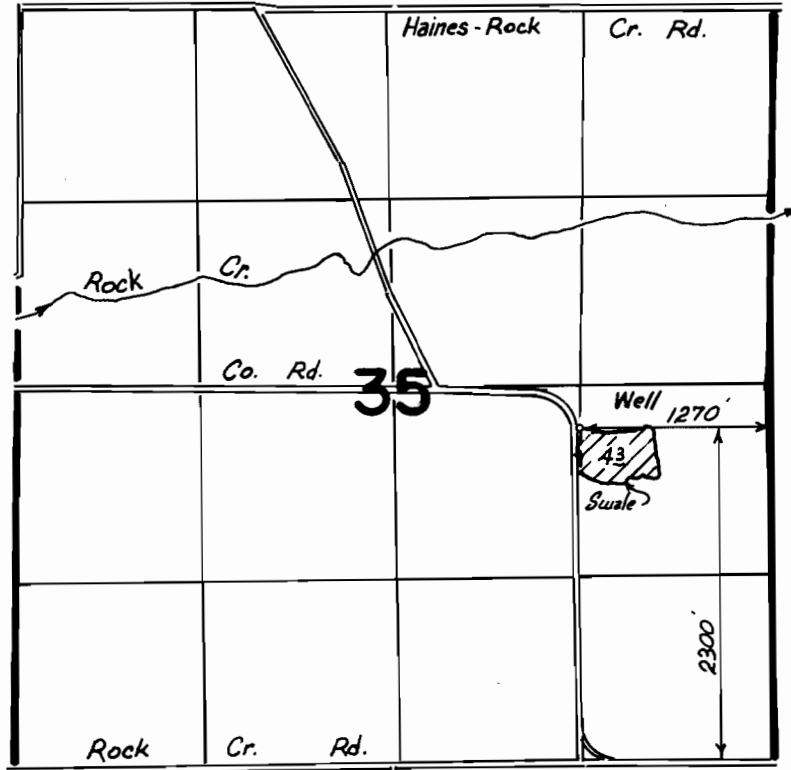

Scale : 1" = 1320'

FINAL PROOF SURVEY UNDER

Application No. G9824 Permit No. G9057

IN NAME OF

LIONEL D. SHURTLEFF

Surveyed 10-1 1987, by Vern Church